

DEC 29 1998

LAND CORNER RECORDATION CERTIFICATE
Filing Requirement of Act 74, Mich. P.A. 1970

LIBER 004 PAGE 0159

For corners in Lake

SECTION

Table with columns: Located In: (20N, 11W), Corner Code # (6-10), and rows for Public Land Survey, Property Controlling in Section, and Miscellaneous Property in Sec.

REGISTER OF DEEDS
OCT 29 4 39 PM '98
LAKE COUNTY, MI.

Register of Deeds Stamp & File Number

4. Lot No. , Recorded Plat
5. Private Claims

Robert L. Wetherell June 4, 98

I, in a field survey on 19 do hereby state that under requirements of P.A. 74, Michigan P.A. of 1970, the corner points mentioned in lines 1 and 2 above were in conformance with regulations and rules therefore as required in the current manual of survey instructions of the United States Department of the Interior, Bureau of Land Management or by a decree of a Court of Law and/or that the corner points mentioned in lines 3, 4 and 5 above were in conformance with the rules of the Michigan Board of Land Surveyors or by a Decree of a Court of Law; established, re-established, monumented, recovered, found as expressed below:

NOTE: Not more than 2 corners, all in the same town and range, may be recorded on this certificate.

Grid table with columns A-M and rows 1-13, containing numerical values for survey points.

A. Description of original monument and accessories and/or subsequent restoration:

G-10 - 1/4 Corner common to Sections 27 & 28, T20N, R11W, Lake Co., Mi.

- 1838 - S. Sibley, G.L.O.
#1 - 16" Hemlock N81°E 26 Links
#2 - 16" Hemlock S86°W 5 Links
1906 - J.W. Nicholson, Co. Sur. Shows corner half way and on line between Section corners.
1919 - G.H. Johnson, Co. Sur. 2-1/2" Iron
#3 - 24" Pine Stump S12°E 66'
#4 - 24" Pine Snag N82°W 22.0' Shows equal distance between Section corners.

- 1996 - R.L. Wetherell, LS 24624
L.C.R.C. - Liber 03, Pg. 423.
1-1/4" x 3/8" Iron
#5 - 6" R. Oak N46°W 23.85'
#6 - 6" Maple S46°W 12.45'
#7 - 4" Maple N84°E 35.31'
#8 - 8" Maple N27°E 67.78'

B. Description of corner evidence found and/or method applied in restoring or reestablishing corner:

G-10 - 1/4 Corner common to Sections 27 & 28, T20N, R11W, Lake Co., Mi.

I found a 3/8" x 1-1/4" iron bar. Distance to the Section corner North is 2774.16 feet and to the Section corner South is 2777.34 feet.

Condition of the accessories are as follows: #1 Gone # Gone, #3 Found stump scribed "1/4", #4 Found remains, #5 Found in good condition, #6 Found in good condition, #7 Found in good condition, #8 Found in good condition.


ATTESTED BY THE LAKE CO. PEER REVIEW GROUP
IN ACCORDANCE WITH P.A. 345
CHAIRMAN R.L.W.
DATE 10-27-98

C. Description of monument for corner and accessories established to perpetuate locating the position of the corner:

G-10 - 1/4 Corner common to Sections 27 & 28, T20N, R11W, Lake Co., Mi.

I replaced the 1-1/4" iron with a 3/4" x 24" re-bar with Lake County Brass Cap, and is accepted as a careful and faithful re-establishment of the position of the original corner.

- 6" R. Oak N46°W 23.85' (60d spike in S.W. side)
6" Maple S46°W 12.45' (60d spike in S.E. side)
4" Maple N84°E 35.31' (60d spike in S. side)
8" Maple N27°E 67.78' (60d spike in W. side)

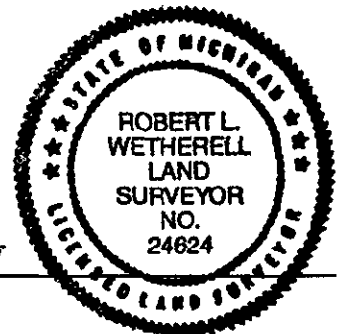

Signed by Robert L. Wetherell
Surveyor's Michigan License No. 24624

Date 10-29-98