

DEC 29 1998

SECTION

LAND CORNER RECORDATION CERTIFICATE  
Filing Requirement of Act 74, Mich. P.A. 1970

LIBER 004 PAGE 0151

For corners in  
Lake \_\_\_\_\_

	Located In:		Corner Code # 1-9
	20N	11W	
1. Public Land Survey	T	R	
	T	R	
	T	R	
	T	R	
2. Property Controlling in Section	S	T	R
	S	T	R
3. Miscellaneous Property in Sec.	S	T	R
	S	T	R

REGISTER OF DEEDS  
*Shirley H. Chabaud*

Oct 29 4 39 PM '98

RECORDED  
LAKE COUNTY, MI.

Register of Deeds Stamp & File Number

4. Lot No. \_\_\_\_\_, Recorded Plat \_\_\_\_\_  
5. Private Claims \_\_\_\_\_

I, Robert L. Wetherell, in a field survey on June 4, 1998 do hereby state that under requirements of P.A. 74, Michigan P.A. of 1970, the corner points mentioned in lines 1 and 2 above were in conformance with regulations and rules therefore as required in the current manual of survey instructions of the United States Department of the Interior, Bureau of Land Management or by a decree of a Court of Law and/or that the corner points mentioned in lines 3, 4 and 5 above were in conformance with the rules of the Michigan Board of Land Surveyors or by a Decree of a Court of Law; established, re-established, monumented, recovered, found as expressed below:

NOTE: Not more than 2 corners, all in the same town and range, may be recorded on this certificate.

	A	B	C	D	E	F	G	H	I	J	K	L	M
1													
2	6		5		4		3		2		1		
3													
4	7		8		9		10		11		12		
5													
6	18		17		16		15		14		13		
7													
8	19		20		21		22		23		24		
9													
10	30		29		28		27		26		25		
11													
12	31		32		33		34		35		36		
13													

A. Description of original monument and accessories and/or subsequent restoration:

I-9 - Section corner common to Sections 22, 23, 26 & 27, T20N, R11W, Lake Co., Mi.

1838 - S. Sibley, G.L.O.

1906 - J. W. Nicholson - Co. Sur.

1911 - G.H. Johnson, Co. Sur.

#1 - 12" Beech S49°E 5 Links

#3 - 14" Beech N68°W 47 Links

"Old stake at corner"

#2 - 14" Hemlock N27°W 38 Links

#4 - 10" Sugar S13°E 107 Links

Iron peg in ground

#5 - 48" Pine stump N33 1/2°E 134 Links

#6 - 8" Maple N79°E 157 Links

(SEE OVER FOR CONTINUATION OF "A")

RATIFIED BY THE LAKE CO. PEER REVIEW GROUP  
IN ACCORDANCE WITH P.A. 345  
CHAIRMAN R.L.W.  
DATE 10-27-98

B. Description of corner evidence found and/or method applied in restoring or reestablishing corner:

I-9 - Section corner common to Sections 22, 23, 26 & 27, T20N, R11W, Lake Co., Mi.

I found a 1/2" x 8" pipe at surface of road, directly below pipe I found a 1/2" x 10" rod, below rod I found a 3 feet long narrow railroad rail. Corner is in the intersection of roads East, West and South and in line with old tree row to North.

Conditions of the accessories are as follows: #1 Gone, #2 Gone, #3 Gone #4 Gone, #5 Found remains of old stump, #6 Gone, #7 Found in good condition, #8 Found in good condition, #9 Found in good condition, #10 Found in good condition, #11 Found in good condition, #12 Found in good condition.

C. Description of monument for corner and accessories established to perpetuate locating the position of the corner:

I-9 - Section corner common to Sections 22, 23, 26 & 27, T20N, R11W, Lake Co., Mi.


I set a 3/4" x 24" re-bar with Lake County Brass Cap directly over the Railroad Rail, and is accepted as a careful and faithful re-establishment of the position of the original corner.

14" R. Pine S59°E 90.82' (60d spike in S.E. side)

20" Maple S38°E 53.37' (Found nail in N.E. side)

34" Maple N43°E 51.00' (60d spike in N.W. side)

12" Maple Clump N50°W 52.34' (60d spike in S.W. side)

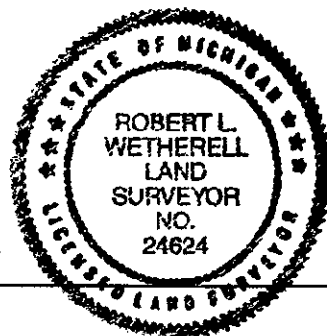

Signed by Robert L. Wetherell  
Surveyor's Michigan License No. 24624

Date 10-29-98

CONTINUATION OF "A" - DESCRIPTION OF ORIGINAL MONUMENT AND ACCESSORIES AND/OR SUBSEQUENT RESTORATION:

1951 - G. Blass, LS 5489

Railroad Iron raised to surface with 1/2" iron.

#7 - 6" Maple N22°E 47.30'

#8 - 12" Maple N3°E 91.49'

1996 - R.L. Wetherell, LS 24624

L.C.R.C. - Liber 003, Page 424

1/2" Pipe

# 9 - 14" R. Pine S59°E 90.82'

#10 - 20" Maple S38°E 53.37'

#11 - 34" Maple N43°E 51.00'

#12 - 12" Maple N50°W 52.34'

SUTNEY &  
REMONUMENTATION

DEC 29 1993

SECTION