

SURVEY & REMONUMENTATION

AUG 31 1999 LAND CORNER RECORDATION CERTIFICATE

FILING REQUIREMENT OF ACT 74, Mich. P.A. 1970

SECTION

RECORDED
LAKE COUNTY, MI.
LIBER 004, PAGE 0206
JUL 23 3 05 PM '99
Christine A. Dickson
REGISTER OF DEEDS

For corners in Lake	Located in:	Corner Code#
1. Public Land Survey	T 20N R 11W	J-9
	T R	
	T R	
	T R	
2. Property Controlling in Section	T R	
S	T R	
3. Miscellaneous Property in Sec.	S T R	
S	T R	
4. Lot No. _____ Recorded Plat	S T R	
5. Private Claims		

Register of Deeds Stamp & File Number

	A	B	C	D	E	F	G	H	I	J	K	L	M
1													
2	6	5	4	3	2	1							
3													
4	7	8	9	10	11	12							
5													
6	18	17	16	15	14	13							
7													
8	19	20	21	22	23	24							
9													
10	30	29	28	27	26	25							
11													
12	31	32	33	34	35	36							
13													

I, Robert L. Wetherell, in a field survey on June 2, 1999, do hereby certify that under requirements of P.A. 74, Michigan P.A. of 1970, the corner points mentioned in lines 1 and 2 above were in conformance with regulations and rules therefore as required in the current manual of survey instructions of the United States Department of the Interior, Bureau of Land Management or by decree of a Court of Law and/or that the corner points mentioned in lines 3, 4, and 5 above were in conformance with the rules of the Michigan Board of Land Surveyors or by a Decree of a Court of Law; established, re-established, monumented, re-monumented, recovered, found as expressed below:

J-9 - 1/4 Corner common to Sections 23 & 26, T20N, R11W

A. Description of original monument and accessories and/or subsequent restoration:

1838 - S. Sibley, G.L.O.

- #1 - 20" Sugar S14°E 31 Links
- #2 14" Beech N28°W 33 Links

1951 - G. Blass, LS 5489

- 1" Iron Pipe
- #5 - 32" Maple N4°W 71.85'
- #3 - 20" Walnut N60°W 69.55'

1998 - R.L. Wetherell, LS 24624

- Survey recorded L. 04, Pg. 298
- #6 - 11" R. Pine N30°E 133.29'
- #7 - 10" R. Pine S26°W 44.05'
- #8 - P. Pole S42°E 110.51'
- #9 - G. Pole N33°W 52.37'

1911 - G.H. Johnson, Co. Sur.

- "Iron Stake in Road"
- #3 - 10" Walnut N61°W 105 Links
- #4 - Stone with "X" on top
- S11-1/2°E 45-1/2 Links

B. Description of corner evidence found and/or method applied in restoring of reestablishing corner:

I found on old 1-1/2" well point 2 feet below road surface. Corner is 6 feet North of centerline of East - West road and in centerline of road to North.


Condition of the accessories are as follows: #1 Gone, #2 Gone, #3 Found in good condition, #4 Gone, #5 Gone, #6 Found in good condition, #7 Found in good condition, #8 Found in good condition, #9 Found in good condition.

C. Description of monument for corner and accessories established to perpetuate locating the position of the corner:

I set a 3/4" x 24" re-bar with Lake County Remon Cap directly over the well point, and is accepted as a careful and faithful re-establishment of the position of the original corner.

- 11" R. Pine N30°E 133.29' (60d spike in N.W. side) #6
- 10" R. Pine S26°W 44.05' (60d spike in W. Side) #7
- P. Pole S42°E 110.51' (Mag Nail in S.W. side) #8
- G. Pole N33°W 52.37' (Mag Nail in S.E. side) #9
- 40" Walnut N55°W 69.6' (center of SCAB on S.W. face of tree)

RATIFIED BY THE LAKE CO. PEER REVIEW GROUP
IN ACCORDANCE WITH P.A. 345
CHAIRMAN *RLW*
DATE *7-20-99*

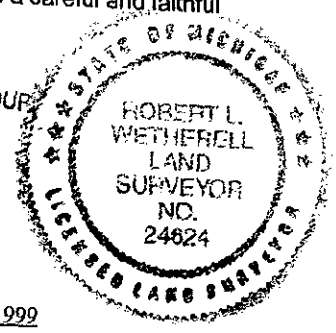

Signed by Robert L. Wetherell
Surveyor's Michigan License No. 24624

Date July 21, 1999