

JAN 25 2001

SECTION

**LAND CORNER RECORDATION CERTIFICATE**

FILING REQUIREMENT OF ACT 74, Mich. P.A. 1970

RECORDED  
LAKE COUNTY, MI.  
LIBER 004 PAGE 0231

MAY 5 10 24 AM '00

*Shelley Myers*  
REGISTER OF DEEDS

For corners in Lake	Located in:	Corner Code#
1. Public Land Survey	T 20N R 11W	L-11
	T R	
	T R	
	T R	
2. Property Controlling in Section	S T R	
	S T R	
3. Miscellaneous Property in Sec.	S T R	
	S T R	
4. Lot No. Recorded Plat		
5. Private Claims		

Register of Deeds Stamp & File Number

	A	B	C	D	E	F	G	H	I	J	K	L	M
1													
2	6	5	4	3	2	1							
3													
4	7	8	9	10	11	12							
5													
6	18	17	16	15	14	13							
7													
8	19	20	21	22	23	24							
9													
10	30	29	28	27	26	25							
11													
12	31	32	33	34	35	36							
13													

I, Robert L. Wetherell, in a field survey on March 20, 2000, do hereby certify that under requirements of P.A. 74, Michigan P.A. of 1970, the corner points mentioned in lines 1 and 2 above were in conformance with regulations and rules therefore as required in the current manual of survey instructions of the United States Department of the Interior, Bureau of Land Management or by decree of a Court of Law and/or that the corner points mentioned in lines 3, 4, and 5 above were in conformance with the rules of the Michigan Board of Land Surveyors or by a Decree of a Court of Law, established, re-established, monumented, re-monumented, recovered, found as expressed below:

**L-11 - 1/4 Corner common to Sections 25 & 36, T20N, R11W**

**A. Description of original monument and accessories and/or subsequent restoration:**

**1838 - S. Sibley, G.L.O.**

- #1 - 8" Beech N4°E 16 Links
- #2 - 8" Beech S3°W 9 Links

**1919 - G.H. Johnson, Co. Sur.**

- 1 1/4" Pipe
- #3 - 18" Elm N72°E 98'

**1996 - P. Case, LS 30079**

- Survey recorded L. 04, Pg. 201
- Found bar & Cap #16929 (J. Erickson)
- #4 - 8" Apple N61°W 36.67'
- #5 - 10" Locust N24°E 57.10'
- #6 - 24" Maple S70°W 59.30'
- #7 - 12" Locust S44°E 41.81'

**1999 - M. McClung, LS 13037**

- Survey recorded L. 04, Pg. 280.
- Found Iron & Cap #16929 (Erickson)
- #8 - P. Pole North 47.55'
- #6 - 24" Maple S66°W 59.5'
- #9 - 15" Cherry N80°E 73.3'
- #10 - S.E. Cor. Rock N56°W 50.4'

**B. Description of corner evidence found and/or method applied in restoring of reestablishing corner:**

I found a 1/2" capped iron (LS 16929) directly over an old 1 1/4" pipe. I also found a large cast iron grate looking object next to the 1 1/4" pipe. At a distance of 4.75 feet South of this 1 1/4" pipe I found two 3/4" pipes on top of each other which were next to an old wood stake and pointed stone. I accepted the 1 1/4" pipe as the corner because I think it is Johnson's from 1919 and because there are 2 recorded surveys tied to it. I have no record of where the pointed stone or iron pipes originated.


Condition of the accessories are as follows: #1 Gone, #2 Gone, #3 Found 8" Elm, possible sprout from Johnson's, #4 Found at 56.47', #5 Found in good condition, #6 Found in good condition, #7 Found in good condition, #7 Found in good condition, #8 Found in good condition, #9 Found in good condition, #10 Found in good condition.

**C. Description of monument for corner and accessories established to perpetuate locating the position of the corner:**

I replaced the 1/2" capped iron and 1 1/4" pipe with a 3/4" x 24" rebar with a Lake County Remon Cap, and is accepted as a careful and faithful reestablishment of the position of the original corner.

- P. Pole N4°E 47.42' (P.K. Nail in W. side) #8
- 8" Apple N55°W 56.47' (60d spike in S.W. side)
- 20" Maple S75°W 59.17' (nail in N. side)
- 20" Maple N71°E 111.24' (60d spike in N.W. side)

CERTIFIED BY THE LAND SURVEYORS REVIEW GROUP  
IN ACCORDANCE WITH P.A. 345  
CHERRMAN, P.d.w.  
DATE 4-11-2000

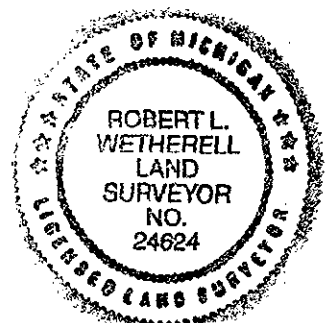

Signed by Robert L. Wetherell  
Surveyor's Michigan License No. 24624

Date April 12, 2000