

**JAN 25 2001**

**LAND CORNER RECORDATION CERTIFICATE**

FILING REQUIREMENT OF ACT 74, Mich. P.A. 1970

For SECTION  
Lake \_\_\_\_\_

Located in: Corner Code#

- |                                      |       |       |        |
|--------------------------------------|-------|-------|--------|
| 1. Public Land Survey                | T 19N | R 11W | M-1    |
|                                      | T 20N | R 11W | M-13 ✓ |
|                                      | T     | R     |        |
|                                      | T     | R     |        |
| 2. Property Controlling in Section   | S     | T     | R      |
|                                      | S     | T     | R      |
| 3. Miscellaneous Property in Sec.    | S     | T     | R      |
|                                      | S     | T     | R      |
| 4. Lot No. _____ Recorded Plat _____ |       |       |        |
| 5. Private Claims _____              |       |       |        |

RECORDED  
LAKE COUNTY, MI.  
LIBER 004 PAGE 0237

May 5 10 25 AM '00

*Shelley Myers*  
REGISTER OF DEEDS

Register of Deeds Stamp & File Number

I, Robert L. Wetherell, in a field survey on January 21, 2000, do hereby certify that under requirements of P.A. 74, Michigan P.A. of 1970, the corner points mentioned in lines 1 and 2 above were in conformance with regulations and rules therefore as required in the current manual of survey instructions of the United States Department of the Interior, Bureau of Land Management or by decree of a Court of Law and/or that the corner points mentioned in lines 3, 4, and 5 above were in conformance with the rules of the Michigan Board of Land Surveyors or by a Decree Of a Court of Law; established, re-established, monumented, re-monumented, recovered, found as expressed below:

	A	B	C	D	E	F	G	H	I	J	K	L	M
1													
2	6	5	4	3	2	1							
3													
4	7	8	9	10	11	12							
5													
6	18	17	16	15	14	13							
7													
8	19	20	21	22	23	24							
9													
10	30	29	28	27	26	25							
11													
12	31	32	33	34	35	36							
13													

**M-1 - N.E. Cor. Sec. 1, T19N, R11W - M-13 - S.E. Cor. Sec. 36, T20N, R11W**

**A. Description of original monument and accessories and/or subsequent restoration:**

**1838 - S. Sibley, G.L.O.**

- #1 - 20" Hemlock N22°W 6 Links
- #2 - 14" Beech S22°E 42 Links

**1891-1904 - Temple/Trumbull/June**

The Township of Leroy (T19N, R10W)  
Was remonumented with 3" Clay Tiles.

**1973 - C. Cole, LS 17615**

- Cultivator Tooth
- L.C.R.C. - Liber 2, Pg. 177
- #3 - 12" Maple N10°E 91.06'
- #4 - P. Pole S56°W 72.98'
- #5 - P. Pole S26°E 57.81'

**1985 - Dean Geers, LS 33977**

- Found Iron & Cap
- #5 - P. Pole S34°E 54.09'
- #7 - 10" Elm S53°W 43.92'
- #8 - 6" Poplar N30°W 89.61'
- #9 - Tele. Riser S40°W 89.61'

**1984 - D. Schripsema, LS 24617**

- "Found iron with shoe on end"
- #5 - P. Pole S40°E 54.13'
- #6 - 24" Willow S18°E 80.74'
- #7 - 10" Ash S52°W 42.52'
- #4 - P. Pole S60°W 73.02'

**1999 - R.L. Wetherell, LS 24624**

- Remonumented for Osceola County.
- L.C.R.C. - Liber "B", Pg. 573
- Found clay tile. Set 1 1/4" Pipe with Osceola Co. Remon Cap.
- #6 - 22" Willow S16°E 85.51'
- #5 - P. Pole S30°E 58.26'
- #7 - 10" Ash S50°W 45.40'
- #4 - P. Pole S58°W 75.47'
- #10 - 3" R. Pine S22°W 85.71'
- #11 - 1/2" Capped Iron (LS 10685) N40°W 43.90'

**B. Description of corner evidence found and/or method applied in restoring of reestablishing corner:**

I found an Osceola Co. Remon Iron in the intersection of roads North, South East and West in 1999. I found a 1/2" capped iron marked LS 10685 (Feldhauser). I did not find Cole's cultivator shoe. From the accessories given, it appears that Cole, Schripsema and Geers were not using the same iron. I made a substantial dig and found the 3" Clay Tile with cinders. The tile was N15°W 4.50 feet from the found 1/2" iron. I accepted the clay tile as the correct corner and set Osceola Co. Remon Iron.


Condition of the accessories are as follows: #1 Gone, #2 Gone, #3 Gone, #4 Found in good condition, #5 Found in good condition, #6 Found in good condition, #7 Found in good condition (ash) #8 Gone, #9 Found in good condition, #10 Found in good condition, #11 Found in good condition.

**C. Description of monument for corner and accessories established to perpetuate locating the position of the corner:**

I accepted the Osceola County Remon Cap in center of 3" tile as a careful and faithful reestablishment of the position of the original corner.

- 22" Willow S16°E 85.51' (60d spike in W. side) #6
- P. Pole S30°E 58.26' (Nail in E. side) #5
- 10" Ash S50°W 45.40' (Nail in N.W. side) #7
- Power Pole S58°W 75.47' (P.K. Nail in S.E. side) #4
- 3" R. Pine S22°W 85.71' (center of tree) #10
- 1/2" Capped Iron (LS 10685) N40°W 43.90' #11

RATIFIED BY THE LAND CORNER REVIEW GROUP  
IN ACCORDANCE WITH P.A. 245  
CHAIRMAN *R.L.W.*  
DATE 4-11-2000

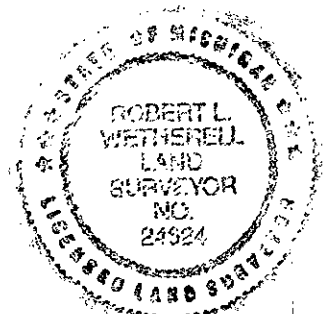

Signed by

*Robert L. Wetherell*

Date April 12, 2000

Surveyor's Michigan License No. 24624