

LAND CORNER RECORDATION CERTIFICATE

FILING REQUIREMENT OF ACT 74, MICH. P.A.1970

FOR CORNERS OF--	LOCATED IN--	CORNER CODE NUMBER
1. PUBLIC LAND SURVEY	T. 20 N. R. 12 W.	M-9; M-10;
2. PROPERTY CONTROLLING IN SECTION 24	T. 20 N. R. 12 W.	7; 14;
3. MISCELLANEOUS PROPERTY IN SECTION	T. N. S. R. E. W.	
4. LOT NO. _____, RECORDED PLAT _____		
5. PRIVATE CLAIMS _____		

REGISTER OF DEEDS STAMP AND FILING NUMBER

I, CARL F. ROSER, do hereby certify that under requirements of P.A. 74, Michigan P.A. of 1970, the corner points mentioned in lines 1 and 2 above were, in a field survey on JUNE 23, 1981, established, re-established, monumented, re-monumented, recovered or restored as expressed below and in conformance with regulations and rules therefore as required in the current manual of survey instructions of the United States Department of the Interior, Bureau of Land Management or by a decree of a court of law. Furthermore, that the corner points mentioned in lines 3, 4 and 5 above were, in a field survey on _____, 19____, found, recovered, restored, established or re-established as expressed below and in conformance with the rules of the Michigan State Board of Registration for Land Surveyors or, by a Decree of a Court of law:

C. CONTINUED

XX

- M-9
- FD 1/2" IRON FLUSH IN CTR N-S BIT RD
- NAIL IN TOP OF GUARD RAIL POST N75°E 18.36'
- NAIL IN SIDE OF POWER POLE S40°W 51.24'
- NAIL IN TOP OF GUARD RAIL POST N40°W 28.49'
- CTR GRAVEL RD WLY DUE S 19' (±2')
- SET CED POST S45°W 60'

- B. Description of corner evidence found and/or method applied in restoring or re-establishing corner:
- 7 - ESTABLISHED SE COR OF N 1/2-NE 1/4 OF S-24 MID-WAY & ON LINE BETWEEN SEC CORNER TO NORTH & 1/4 CORNER TO SOUTH. CORNER IS IN LINE WITH FENCES TO EAST & WEST. AN OLD LEANING CORNER FENCE POST IS 48.3' WEST.
 - 14 FD 1/2" IR WITH RLS CAP #12016, GORDAN BONNEY FOR S 1/8 CORNER ON E. LINE OF SEC 24. COR FALLS IN CTR OF N-S BIT SURFACE ROAD.
 - M-9 FD 1/2" IRON IN CTR OF N-S BIT SURFACE ROAD AND USED RLS, JIM FLETCHERS 1974 WITS.
 - M-10 FD 3/8" IRON ROD IN CTR OF N-S BIT. SURFACE ROAD. FD THREE OF RLS, JIM FLETCHERS 1974 WITS AND USED TWO OF THEM.

- C. Description of monument for corner and accessories established to perpetuate locating the position of the corner:
- | | | |
|---------------------------------|-----------------------------------|---|
| | 14 | M-10 |
| 7 | | |
| DRIVE 5/8"X36" RE-ROD W/RLS CAP | FD 1/2" IR. IN CTR N-S BIT TOP RD | FD 3/8" IR ROD IN CTR N-S BIT RD; RAISED TO SURFACE W/1"X18" PIPE |
| 10" R. PINE N80°W 65.3' | 8" S. MAPLE S50°W 61.4' | 12" MAPLE S15°E 97.12' |
| EN COR (N-S-E) EAST 17.42' | 11" TWIN S. MAPLE N60°E 40.4' | 27" R. OAK S45°W 58.04' |
| CTR N-S BIT RD DUE W 13' | 8" S. MAPLE S45°E 52.6' | SET CED POST DUE W 33' |
| SET CED POST | SET CED POST | |
| W/LOC TAG DUE W 50' | BESIDE 1/2" IRON WEST 33' | |


SIGNED BY Carl F. Roser DATE 4-05-82

SURVEYOR'S MICHIGAN REGISTRATION NO. 12028

FOR STATE AND UNITED STATES AGENCIES:

SIGNED BY _____ DATE _____

APPROVED AND SIGNED BY _____ DATE _____

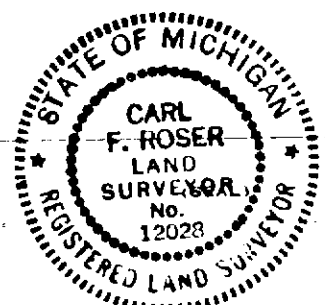

SURVEYOR'S MICHIGAN REGISTRATION NO. _____ LAKE COUNTY