

LAND CORNER RECORDATION CERTIFICATE

FILING REQUIREMENT OF ACT 74, MICH. P.A.1970

FOR CORNERS OF--:	LOCATED IN--:	CORNER CODE NUMBER
1. PUBLIC LAND SURVEY _____	T. 20 ^{N.} <input checked="" type="radio"/> R. 12 ^{W.} <input checked="" type="radio"/>	F-11; G-10; G-11
2. PROPERTY CONTROLLING IN SECTION 28 _____	T. 20 ^{N.} <input checked="" type="radio"/> R. 12 ^{W.} <input checked="" type="radio"/>	16
3. MISCELLANEOUS PROPERTY IN SECTION _____	T. _____ ^{N.} <input type="radio"/> R. _____ ^{E.} <input type="radio"/>	_____
4. LOT NO. _____, RECORDED PLAT _____		
5. PRIVATE CLAIMS _____		

REGISTER OF DEEDS STAMP AND FILING NUMBER

I, Carl F. Roser do hereby certify that under requirements of P.A. 74, Michigan P.A. of 1970, the corner points mentioned in lines 1 and 2 above (identified with circles on index code diagram - over) were, in a field survey on January 15, 1974, established, re-established, monumented, re-monumented, recovered or restored as expressed below and in conformance with regulations and rules therefore as required in the current manual of survey instructions of the United States Department of the Interior, Bureau of Land Management or by a decree of a court of law. Furthermore, that the corner points mentioned in lines 3, 4 and 5 above were, in a field survey on _____ 19____, found, recovered, restored, established or re-established as expressed below and in conformance with the rules of the Michigan State Board of Registration for Land Surveyors or, by a Decree of a Court of law:

A. Description of original monument and accessories and/or subsequent restoration:

B. Description of corner evidence found and/or method applied in restoring or re-establishing corner:

- F-11 Restored corner per standard B.L.M. instructions.
- G-10 Restored corner per standard B.L.M. instructions.
- G-11 Recovered G. Johnson stake from two of his witnesses.
- 16 Established corner per standard B.L.M. instructions.

C. Description of monument for corner and accessories established to perpetuate locating the position of the corner:

F-11	G-10	G-11
Set DNR mon. on 4.5" pipe & cedar post	Set DNR mon. & cedar post	Fd. stake, added DNR mon. on 5' pipe & cedar post
5" Cedar N10°E 32.3	6" Maple S45°E 54.5	12" Cedar N85°E 24.3
7" Hemlock N80°E 26.3	5" Maple N80°W 34.8	11" Cedar S22°E 22.4
5" Cedar S70°E 29.6	5" Maple S42°W 25.6	10" Cedar S25°W 39.7
	16	
	Set 1"x6' pipe & cedar post w/loc. tag	
	8" Cedar S50°E 4.2	
	5" Cedar N70°E 5.0	


SIGNED BY Carl F. Roser 8-8-74 DATE _____

SURVEYOR'S MICHIGAN REGISTRATION NO. 12028

FOR STATE AND UNITED STATES AGENCIES:

SIGNED BY _____ DATE _____
CHIEF OF SURVEY PARTY

APPROVED AND SIGNED BY _____ DATE _____
MICHIGAN REGISTERED LAND SURVEYOR

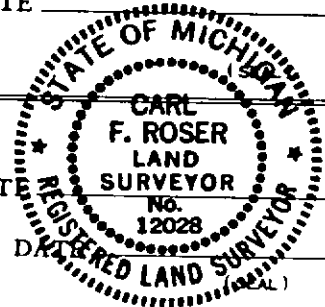

NORTH NEWKIRK TOWNSHIP
LAKE COUNTY