

LAND CORNER RECORDATION CERTIFICATE

FILING REQUIREMENT OF ACT 74, MICH. P.A. 1970

FOR CORNERS OF--	LOCATED IN--	CORNER CODE NUMBER
1. PUBLIC LAND SURVEY _____	T. 20 ^{N.} R. 12 ^{W.}	C-11; D-11; E-11
2. PROPERTY CONTROLLING IN SECTION 29 _____	T. 20 ^{N.} R. 12 ^{W.}	15
3. MISCELLANEOUS PROPERTY IN SECTION _____	T. _____ ^{N.} R. _____ ^{E.}	
4. LOT NO. _____, RECORDED PLAT _____		
5. PRIVATE CLAIMS _____		

REGISTER OF DEEDS STAMP AND FILING NUMBER

I, Carl F. Roser do hereby certify that under requirements of P.A. 74, Michigan P.A. of 1970, the corner points mentioned in lines 1 and 2 above (identified with circles on index code diagram—over) were, in a field survey on January 8, 1974, established, re-established, monumented, re-monumented, recovered or restored as expressed below and in conformance with regulations and rules therefore as required in the current manual of survey instructions of the United States Department of the Interior, Bureau of Land Management or by a decree of a court of law. Furthermore, that the corner points mentioned in lines 3, 4 and 5 above were, in a field survey on _____ 19____, found, recovered, restored, established or re-established as expressed below and in conformance with the rules of the Michigan State Board of Registration for Land Surveyors or, by a Decree of a Court of law:

~~A. Description of original monument, accessories and/or subsequent monuments~~
 C. (continued)

15
 Set 1"x30" pipe & cedar post
 w/location tag
 18" R. Pine S50°E 35.8
 19" W. Pine N60°W 15.2

- B. Description of corner evidence found and/or method applied in restoring or re-establishing corner:
- C-11 Recovered G. Blass iron in road intersection.
 - D-11 Restored corner per standard B.L.M. instructions.
 - E-11 Restored corner by double proportion per standard B.L.M. instructions.
 - 15 Established corner per standard B.L.M. instructions.

C. Description of monument for corner and accessories established to perpetuate locating the position of the corner:

C-11	D-11	E-11
Found 3/4" pipe (buried)	Set DNR monument & cedar post	Set DNR monument on 1"x4.5' pipe & cedar post
14" B. Oak S48°E 29.6	2" W. Pine N20°W 9.4	5" Cedar N10°E 50.0
7" B. Oak S60°W 62.3	9" W. Pine S55°E 85.4	9" Cedar S40°E 15.2
10" J. Pine N42°E 54.0	19" R. Oak Due W 13.8	6" Cedar S47°W 47.2
Set cedar post w/loc. tag		6" Maple N32°W 7.3
Due E 33'		


SIGNED BY Carl F. Roser 8-8-74 DATE

SURVEYOR'S MICHIGAN REGISTRATION NO. 12028

FOR STATE AND UNITED STATES AGENCIES:

SIGNED BY _____ DATE _____
CHIEF OF SURVEY PARTY

APPROVED AND SIGNED BY _____ DATE _____
MICHIGAN REGISTERED LAND SURVEYOR

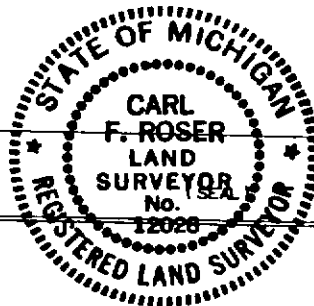

(SEAL)

SURVEYOR'S MICHIGAN REGISTRATION NO. _____

NORTH NEWKIRK TOWNSHIP
 LAKE COUNTY