

LAND CORNER RECORDATION CERTIFICATE

FILING REQUIREMENT OF ACT 74, MICH. P.A.1970

FOR CORNERS OF--:	LOCATED IN--:	CORNER CODE NUMBER
1. PUBLIC LAND SURVEY.....	T. 20 N. R. 12 W.	G-4
2. PROPERTY CONTROLLING IN SECTION 9	T. 20 N. R. 12 W.	14
3. MISCELLANEOUS PROPERTY IN SECTION 9	T. 20 N. R. 12 W. (XX = 668.3' S of E-4 & 2005.0' N of E-5)	XX
4. LOT NO. _____, RECORDED PLAT _____		
5. PRIVATE CLAIMS _____		

REGISTER OF DEEDS STAMP AND FILING NUMBER

I, Carl F. Roser do hereby certify that under requirements of P.A. 74, Michigan P.A. of 1970, the corner points mentioned in lines 1 and 2 above (identified with circles on index code diagram - over) were, in a field survey on July 25, 1974, established, re-established, monumented, re-monumented, recovered or restored as expressed below and in conformance with regulations and rules therefore as required in the current manual of survey instructions of the United States Department of the Interior, Bureau of Land Management or by a decree of a court of law. Furthermore, that the corner points mentioned in lines 3, 4 and 5 above were, in a field survey on _____ 19____, found, recovered, restored, established or re-established as expressed below and in conformance with the rules of the Michigan State Board of Registration for Land Surveyors or, by a Decree of a Court of law:

A. Description of original monument and accessories and/or subsequent restoration:


B. Description of corner evidence found and/or method applied in restoring or re-establishing corner:

- G-4 Recovered 1"x15" pipe (added 1"x36" pipe) in crooked E-W trail road from two F. Jones witnesses.
- 14 Established corner per standard B.L.M. instructions.
- XX Established corner at SW corner of N $\frac{1}{2}$ -N $\frac{1}{2}$ -SW $\frac{1}{4}$ of Section 9; between found $\frac{1}{2}$ corner north and section corner south.

C. Description of monument for corner and accessories established to perpetuate locating the position of the corner:

G-4	14	XX
Found & accepted 1" pipe (buried)	Set 1"x35" pipe & cedar post w/loc. tag	Set 1"x36" pipe, buried in N-S sand road
12" Maple (clmp. of 5) N72 ⁰ W 59.1	18" Oak S25 ⁰ E 23.0	7" Oak N75 ⁰ E 30.0
13" Oak S02 ⁰ E 45.8	3" Maple S65 ⁰ W 5.6	8" J. Pine N83 ⁰ W 32.5
6" Maple S30 ⁰ W 32.7		Set cedar post w/loc. tag
Set cedar post w/loc. tag		Due E 33'
Due N 33'		$\frac{1}{2}$ " Ref. rod Due W 33.0

SIGNED BY Carl F. Roser DATE 8/17/74
 SURVEYOR'S MICHIGAN REGISTRATION NO. 12028

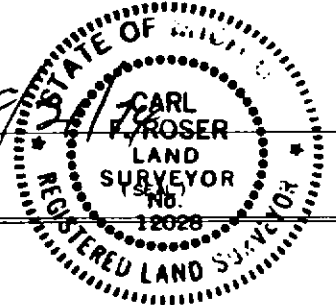

FOR STATE AND UNITED STATES AGENCIES:
 SIGNED BY _____ DATE _____
CHIEF OF SURVEY PARTY
 APPROVED AND SIGNED BY _____ DATE _____
MICHIGAN REGISTERED LAND SURVEYOR (SEAL)

SURVEYOR'S MICHIGAN REGISTRATION NO. _____ NORTH NEWKIRK TOWNSHIP
 LAKE COUNTY