

# LAND CORNER RECORDATION CERTIFICATE

FILING REQUIREMENT OF ACT 74, MICH. P.A.1970

FOR CORNERS OF--:	LOCATED IN--:	CORNER CODE NUMBER
1. PUBLIC LAND SURVEY	T. 20 N. R. 12 W.	C-13; I-11; I-13
2. PROPERTY CONTROLLING IN SECTION 32	T. 20 N. R. 12 W.	14
3. MISCELLANEOUS PROPERTY IN SECTION	T. S. R. E. W.	
4. LOT NO. _____, RECORDED PLAT _____		
5. PRIVATE CLAIMS _____		

REGISTER OF DEEDS STAMP AND FILING NUMBER

I, Carl F. Roser do hereby certify that under requirements of P.A. 74, Michigan P.A. of 1970, the corner points mentioned in lines 1 and 2 above (identified with circles on index code diagram - over) were, in a field survey on July 29, 1974, established, re-established, monumented, re-monumented, recovered or restored as expressed below and in conformance with regulations and rules therefore as required in the current manual of survey instructions of the United States Department of the Interior, Bureau of Land Management or by a decree of a court of law. Furthermore, that the corner points mentioned in lines 3, 4 and 5 above were, in a field survey on \_\_\_\_\_ 19\_\_\_\_, found, recovered, restored, established or re-established as expressed below and in conformance with the rules of the Michigan State Board of Registration for Land Surveyors or, by a Decree of a Court of law:

~~A. Description of original monument and accessories and/or subsequent restoration~~

C. (continued) 14  
 Set 1"x30" pipe & cedar post w/loc. tag  
 6" W. Pine      N05°E      38.6  
 7" Maple      S45°E      42.8  
 5" Maple      S53°W      22.2

B. Description of corner evidence found and/or method applied in restoring or re-establishing corner:

- C-13 Recovered 1 1/4" pipe as found and accepted by RLS Geo. Blass in 1948. Also fits Blass witnesses from 1948. Corner is in approximate intersection of dirt road N-S-W and was used by Blass to split up Sec. 31 in 1948. Corner appears to be 100'± too far south but is being recorded as found and used by previous RLS.
- I-11 Found iron in center of N-S road, 2' s. of fence to east. Corner fits three G. Johnson B.T. stumps.
- I-13 Recovered 1 1/4" pipe and possible G. Johnson witness.
- 14 Established corner per standard B.L.M. instructions.


C. Description of monument for corner and accessories established to perpetuate locating the position of the corner:

C-13	I-11	I-13
Found 1 1/4" pipe buried in N-S dirt rd.	Found & accepted 1" iron	Found & accepted 1 1/4" pipe
12" B. Oak      N19°W      75.10	23" Maple      N28°W      48.53	5" Maple      N77°W      43.6
18" Twn. B. Oak      S77°W      115.15	6" Maple      N68°E      28.27	Set cedar post w/loc. tag
8" B. Oak      S65°E      33.2	19" Maple      S45°W      32.71	Due W      16 1/2'
Set cedar post w/loc. tag Due E 33'	Set loc. tag on T. Pole	N-S Bit. rd. Due E 15'
NE S-6 (19-12)      N86°30'E      36.2	N87°W      29'	NW Sec. 2      East      51.48

SIGNED BY Carl F. Roser

DATE \_\_\_\_\_

SURVEYOR'S MICHIGAN REGISTRATION NO. 12028

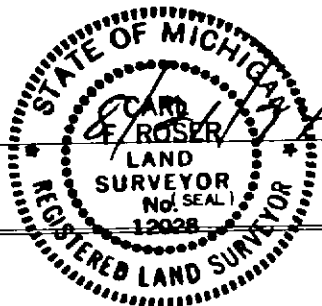

FOR STATE AND UNITED STATES AGENCIES:

SIGNED BY \_\_\_\_\_ CHIEF OF SURVEY PARTY

DATE \_\_\_\_\_

APPROVED AND SIGNED BY \_\_\_\_\_ MICHIGAN REGISTERED LAND SURVEYOR

DATE \_\_\_\_\_

(SEAL)

SURVEYOR'S MICHIGAN REGISTRATION NO. \_\_\_\_\_

NORTH NEWKIRK TOWNSHIP  
LAKE COUNTY