

LAND CORNER RECORDATION CERTIFICATE

FILING REQUIREMENT OF ACT 74, MICH. P.A.1970

FOR CORNERS OF --:	LOCATED IN --:	CORNER CODE NUMBER
1. PUBLIC LAND SURVEY _____	T. 20 N. R. 12 W. ●	E-12; G-12
2. PROPERTY CONTROLLING IN SECTION 33 _____	T. 20 N. R. 12 W. ●	14; 15
3. MISCELLANEOUS PROPERTY IN SECTION _____	T. _____ N. S., R. _____ E. W.	
4. LOT NO. _____, RECORDED PLAT _____		
5. PRIVATE CLAIMS _____		

REGISTER OF DEEDS STAMP AND FILING NUMBER

I, Carl F. Roser do hereby certify that under requirements of P.A. 74, Michigan P.A. of 1970, the corner points mentioned in lines 1 and 2 above (identified with circles on index code diagram - over) were, in a field survey on June 25, 1974, established, re-established, monumented, re-monumented, recovered or restored as expressed below and in conformance with regulations and rules therefore as required in the current manual of survey instructions of the United States Department of the Interior, Bureau of Land Management or by a decree of a court of law. Furthermore, that the corner points mentioned in lines 3, 4 and 5 above were, in a field survey on _____ 19____, found, recovered, restored, established or re-established as expressed below and in conformance with the rules of the Michigan State Board of Registration for Land Surveyors or, by a Decree of a Court of law:

A. Description of original monument and accessories and of subsequent restoration

C. (continued)

- 15
- Set 1"x36" pipe & cedar post w/loc. tag
- 2" W. Pine N50°W 32.4
- 13" J. Pine N30°E 32.3
- W-1/16 N. line Sec. 4
- N89°38'E 39.60
- Center E-W trail rd. Due S 40'


B. Description of corner evidence found and/or method applied in restoring or re-establishing corner:

- E-12 Recovered angle iron and remains of two G. Johnson witnesses.
- G-12 Reestablished corner per standard B.L.M. instructions.
- 14 Established corner per standard B.L.M. instructions.
- 15 Established corner per standard B.L.M. instructions.

C. Description of monument for corner and accessories established to perpetuate locating the position of the corner:

	E-12	G-12	14
Found iron, added DNR monument & cedar post		Set DNR mon. & cedar post	Set 1"x5' pipe & cedar post w/loc. tag
8" W. Pine N13°W 78.1	5" Cedar N60°W 18.4	13" W. Pine S80°E 8.0	6" Cedar N35°E 64.1
5" Cedar N35°E 51.5	5" Cedar S35°W 15.3	11" Cedar S83°W 26.2	5" Maple S73°E 27.8
NE'ly leg of steel tower #3860 S30°E 296.2			

SIGNED BY Carl F. Roser
 SURVEYOR'S MICHIGAN REGISTRATION NO. 12028

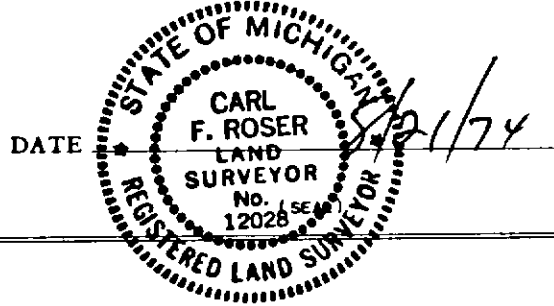

FOR STATE AND UNITED STATES AGENCIES:

SIGNED BY _____ DATE _____
CHIEF OF SURVEY PARTY

APPROVED AND SIGNED BY _____ DATE _____
MICHIGAN REGISTERED LAND SURVEYOR

SURVEYOR'S MICHIGAN REGISTRATION NO. _____
 NORTH NEWKIRK TOWNSHIP
 LAKE COUNTY