

LAND CORNER RECORDATION CERTIFICATE

FILING REQUIREMENT OF ACT 74, MICH. P.A.1970

FOR CORNERS OF -:	LOCATED IN -:	CORNER CODE NUMBER
1. PUBLIC LAND SURVEY _____	T. 20 N. ● R. 12 W. ●	H-11; J-7; K-7; L-7
2. PROPERTY CONTROLLING IN SECTION 27 _____	T. 20 N. ● R. 12 W. ●	15
3. MISCELLANEOUS PROPERTY IN SECTION _____	T. _____ N. _____ S. _____ R. _____ E. _____ W. _____	_____
4. LOT NO. _____, RECORDED PLAT _____		
5. PRIVATE CLAIMS _____		

REGISTER OF DEEDS STAMP AND FILING NUMBER

I, Carl F. Roser do hereby certify that under requirements of P.A. 74, Michigan P.A. of 1970, the corner points mentioned in lines 1 and 2 above (identified with circles on index code diagram - over) were, in a field survey on June 28, 1974, established, re-established, monumented, re-monumented, recovered or restored as expressed below and in conformance with regulations and rules therefore as required in the current manual of survey instructions of the United States Department of the Interior, Bureau of Land Management or by a decree of a court of law. Furthermore, that the corner points mentioned in lines 3, 4 and 5 above were, in a field survey on _____ 19____, found, recovered, restored, established or re-established as expressed below and in conformance with the rules of the Michigan State Board of Registration for Land Surveyors or, by a Decree of a Court of law:

A. Description of original monument and accessories and/or subsequent restorations

C. (continued)	L-7	15	
	Found stake, added DNR mon. & cedar post	Set 1 1/4"x42" pipe & cedar post w/loc. tag	
	5" Cedar S28°E 15.8	7" Maple N65°E 8.0	
	7" Cedar S45°W 16.9	6" Maple S25°E 4.3	
	9" Cedar S62°W 24.4	12" Hemlock S65°W 37.9	
	3' stream C-E'ly Due S 99'	N-S fence remains	
		Due E 135'±	


B. Description of corner evidence found and/or method applied in restoring or re-establishing corner:

- H-11 Reestablished corner per standard B.L.M. instructions.
- J-7 Reestablished corner on line and equidistant between sec. corners to E & W. Corner falls in old E-W fence remains & fits possible G. Johnson witness stump.
- K-7 Restored corner by rotted off corner fence post, fence remains S & W, which fits G. Johnson & J. W. Nichoson witness.
- L-7 Recovered stake bottom from G. Johnson & J. W. Nichoson (1903) witness.
- 15 Established corner per standard B.L.M. instructions.

C. Description of monument for corner and accessories established to perpetuate locating the position of the corner:

H-11	J-7	K-7
Set DNR monument buried 1' No witness available. corner falls in hayfield.	Set DNR monument & cedar post 10" R. Pine N25°W 35.7 10" B. Oak N50°E 5.9 4" Maple S20°E 11.6	Set DNR monument & cedar post 10" W. Oak N45°E 23.3 5" Cedar S15°W 53.5 6" Cedar S45°W 64.9 1 1/2' stream C-E'ly Due S 52'

SIGNED BY Carl F. Roser

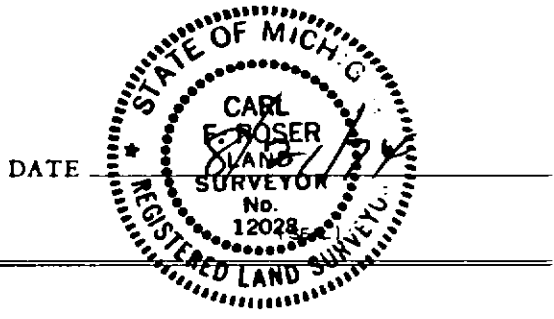

SURVEYOR'S MICHIGAN REGISTRATION NO. 12028

FOR STATE AND UNITED STATES AGENCIES:

SIGNED BY _____ DATE _____
CHIEF OF SURVEY PARTY

APPROVED AND SIGNED BY _____ DATE _____
MICHIGAN REGISTERED LAND SURVEYOR

(SEAL)

SURVEYOR'S MICHIGAN REGISTRATION NO. _____ NORTH NEWKIRK TOWNSHIP
LAKE COUNTY