

LAND CORNER RECORDATION CERTIFICATE

FILING REQUIREMENT OF ACT 74, MICH. P.A.1970

FOR CORNERS OF—:	LOCATED IN—:	CORNER CODE NUMBER
1. PUBLIC LAND SURVEY_____	T. 20 N. R. 12 ● W.	D-9; E-7; E-10
2. PROPERTY CONTROLLING IN SECTION 29	T. 20 N. R. 12 ● W.	2
3. MISCELLANEOUS PROPERTY IN SECTION _____	T. _____ N. S., R. _____ E. W.	_____
4. LOT NO. _____, RECORDED PLAT _____		
5. PRIVATE CLAIMS _____		

REGISTER OF DEEDS STAMP AND FILING NUMBER

I, Carl F. Roser do hereby certify that under requirements of P.A. 74, Michigan P.A. of 1970, the corner points mentioned in lines 1 and 2 above (identified with circles on index code diagram—over) were, in a field survey on December 20, 1973, established, re-established, monumented, re-monumented, recovered or restored as expressed below and in conformance with regulations and rules therefore as required in the current manual of survey instructions of the United States Department of the Interior, Bureau of Land Management or by a decree of a court of law. Furthermore, that the corner points mentioned in lines 3, 4 and 5 above were, in a field survey on _____ 19____, found, recovered, restored, established or re-established as expressed below and in conformance with the rules of the Michigan State Board of Registration for Land Surveyors or, by a Decree of a Court of law:

A. Description of monument and accessories established to perpetuate locating the position of the corner:

C. (continued) 2

Set 1"x6' pipe & cedar post
w/loc. tag

24" Maple	N35°W	20.0
17" Maple	S40°E	16.6
5" Cedar	S85°W	17.6

B. Description of corner evidence found and/or method applied in restoring or re-establishing corner:


- D-9 Restored corner per standard B.L.M. instructions.
- E-7 Recovered stake that fits two U.S.B.T. stumps and F. Jones witness.
- E-10 Restored corner per standard B.L.M. instructions.
- 2 Established corner per standard B.L.M. instructions.

C. Description of monument for corner and accessories established to perpetuate locating the position of the corner:

D-9	E-7	E-10
Set DNR mon. on 1"x7.5' pipe & cedar post	Fd. stake, added DNR mon & cedar post	Set DNR mon. on 1"x5' pipe & cedar post
11" W. Birch N33°E 173.0	15" B. Oak N53°W 27.2	7" Ash N40°W 50.6
13" W. Birch N80°E 220.4	13" B. Oak N40°E 56.1	8" Ash N30°E 34.0
7" Ash S70°W 68.2	19" B. Oak S30°E 52.9	22" Maple S38°E 82.2
	12" J. Pine S50°W 34.2	

SIGNED BY Carl F. Roser 8-8-74 DATE _____

SURVEYOR'S MICHIGAN REGISTRATION NO. 12028

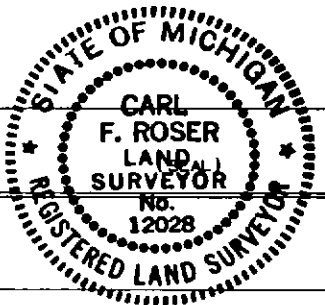

FOR STATE AND UNITED STATES AGENCIES:

SIGNED BY _____ DATE _____
CHIEF OF SURVEY PARTY

APPROVED AND SIGNED BY _____ DATE _____
MICHIGAN REGISTERED LAND SURVEYOR

(SEAL)

NORTH NEWKIRK TOWNSHIP
LAKE COUNTY

SURVEYOR'S MICHIGAN REGISTRATION NO. _____