

# LAND CORNER RECORDATION CERTIFICATE

## FILING REQUIREMENT OF ACT 74. MICH. P.A.1970

FOR CORNERS OF--:	LOCATED IN--:	CORNER CODE NUMBER
1. PUBLIC LAND SURVEY _____	T. 20 <sup>N.</sup> <input checked="" type="radio"/> , R. 12 <sup>W.</sup> <input checked="" type="radio"/>	C-5;C-6;C-7;D-7
2. PROPERTY CONTROLLING IN SECTION _____	T. _____, <sup>N.</sup> <input type="radio"/> , <sup>S.</sup> <input type="radio"/> R. _____, <sup>E.</sup> <input type="radio"/> , <sup>W.</sup> <input type="radio"/>	_____
3. MISCELLANEOUS PROPERTY IN SECTION _____	T. _____, <sup>N.</sup> <input type="radio"/> , <sup>S.</sup> <input type="radio"/> R. _____, <sup>E.</sup> <input type="radio"/> , <sup>W.</sup> <input type="radio"/>	_____
4. LOT NO. _____, RECORDED PLAT _____		
5. PRIVATE CLAIMS _____		

REGISTER OF DEEDS STAMP AND FILING NUMBER

I, Carl F. Roser do hereby certify that under requirements of P.A. 74, Michigan P.A. of 1970, the corner points mentioned in lines 1 and 2 above (identified with circles on index code diagram - over) were, in a field survey on December 28, 1973, established, re-established, monumented, re-monumented, recovered or restored as expressed below and in conformance with regulations and rules therefore as required in the current manual of survey instructions of the United States Department of the Interior, Bureau of Land Management or by a decree of a court of law. Furthermore, that the corner points mentioned in lines 3, 4 and 5 above were, in a field survey on \_\_\_\_\_ 19\_\_\_\_, found, recovered, restored, established or re-established as expressed below and in conformance with the rules of the Michigan State Board of Registration for Land Surveyors or, by a Decree of a Court of law:

**A. Description of original monumented accessories and of subsequent restoration**

C. (continued) D-7  
 Found pipe, added DNR monument & cedar post  
 9" J. Pine N13°W 75.0  
 9" J. Pine S57°W 61.6  
 Center N-S railroad grade  
 Due W 8'

**B. Description of corner evidence found and/or method applied in restoring or re-establishing corner:**

- C-5 Recovered and accepted G. Blass iron in intersection of roads N-S-E-W.
- C-6 Recovered an iron which fits F. Jones witness. Corner falls in center of N-S dirt road.
- C-7 Recovered G. Blass iron in road intersection.
- D-7 Recovered pipe per two F. Jones witnesses.

**C. Description of monument for corner and accessories established to perpetuate locating the position of the corner:**

C-5	C-6	C-7
Found & accepted fence post iron	Found fence post iron, added	Found & accepted 1" pipe
8" J. Pine N24°W 93.0	1"x27" pipe	5" J. Pine N64°E 41.50
12" B. Oak N67°E 83.3	9" J. Pine S52°E 54.6	8" Oak N69°W 66.95
10" B. Oak S65°W 119.0	6" B. Oak S30°W 54.9	5" J. Pine S56°W 67.0
Set cedar post w/loc. tag	Set cedar post w/loc. tag	6" R. Oak S32°E 43.66
S45°W 66'	Due W 33'	Set cedar post w/loc. tag
		S45°E 33'


SIGNED BY Carl F. Roser 8-8-74 DATE \_\_\_\_\_

SURVEYOR'S MICHIGAN REGISTRATION NO. 12028

FOR STATE AND UNITED STATES AGENCIES:

SIGNED BY \_\_\_\_\_ CHIEF OF SURVEY PARTY DATE \_\_\_\_\_

APPROVED AND SIGNED BY \_\_\_\_\_ MICHIGAN REGISTERED LAND SURVEYOR DATE \_\_\_\_\_

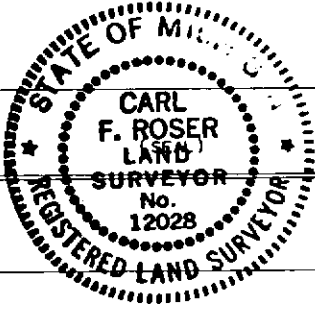

NORTH NEWKIRK TOWNSHIP  
LAKE COUNTY

SURVEYOR'S MICHIGAN REGISTRATION NO. \_\_\_\_\_