

LAND CORNER RECORDATION CERTIFICATE

FILING REQUIREMENT OF ACT 74, MICH. P.A. 1970

FOR CORNERS OF--	LOCATED IN--	CORNER CODE NUMBER
1. PUBLIC LAND SURVEY _____ T. <u>20</u> N. <u>12</u> W. <u>12</u> #.		D-3, D-4, D-5, E-4, E-5 F-3, F-5
2. PROPERTY CONTROLLING IN SECTION _____ T. _____ N. _____ S. _____ R. _____ E. _____ W. _____		
3. MISCELLANEOUS PROPERTY IN SECTION _____ T. _____ N. _____ S. _____ R. _____ E. _____ W. _____		
4. LOT NO. _____, RECORDED PLAT _____		
5. PRIVATE CLAIMS _____		

STATE OF MICHIGAN
COUNTY OF LAKE
RECORDED
15 1974
O'CLOCK
REGISTER OF DEEDS
REGISTER OF DEEDS STAMP AND FILING NUMBER

I, Clinton E. Cole do hereby certify that under requirements of P.A. 74, Michigan P.A. of 1970, the corner points mentioned in lines 1 and 2 above (identified with circles on index code diagram - over) were, in a field survey on _____ 19____, established, re-established, monumented, re-monumented, recovered or restored as expressed below and in conformance with regulations and rules therefore as required in the current manual of survey instructions of the United States Department of the Interior, Bureau of Land Management or by a decree of a court of law. Furthermore, that the corner points mentioned in lines 3, 4 and 5 above were, in a field survey on May 24, 1973, found, recovered, restored, established or re-established as expressed below and in conformance with the rules of the Michigan State Board of Registration for Land Surveyors or, by a Decree of a Court of law:

C. Continued (Additional Work by DNR Surveyor, C. Roser, RLS #12028) July, 1974

E-4 (E $\frac{1}{4}$ S-8); accepted Clint Cole Cor. Set Ced. Post W/Loc. Tag Due W. 33'	D-4 (Ctr. S-8); accepted Clint Cole Cor. Added Ced. Post W/loc. tag at Cor.
F-5 (S $\frac{1}{2}$ S-9); accepted Clint Cole Cor. Set Ced. Post W/Loc. Tag Due S 33'	D-5 (S $\frac{1}{4}$ S-8); accepted Clint Cole Cor. Set Ced Post W/loc. tag Due N 33'
D-3 (N $\frac{1}{4}$ S-8); accepted Clint Cole Cor. Set Ced. Post W/loc. tag Due S 33'	E-5 (SE S-8); accepted Clint Cole Cor. Set Ced. Post W/loc. tag S45W 33'

B. Description of corner evidence found and/or method applied in restoring or re-establishing corner:

D-3 Set 1/2" rebar midway & on line between Sec. Cors.	D-4 Ctr S-8 Set 1/2" Re-bar at intersection of 1/4 lines	D-5 S $\frac{1}{4}$ S-8 Fd. iron pin, set conc. Mon.
E-4 Set Conc. Mon mid-way & on line between Sec. Cors.	E-5 SE S-8 Fd. iron pin, Set Conc. Mon.	F-3 S $\frac{1}{4}$ S-4 or N $\frac{1}{4}$ S-9 Fd. 1/2" rod & cedar post & O.B.T.

F-5 Set Conc. Mon. from O.B.T. & recorded distance from G-5.

C. Description of monument for corner and accessories established to perpetuate locating the position of the corner:

D-3 12" J. Pine N58W 67.05 8" J. Pine N10E 72.41 6" J. Pine S26E 73.67	D-4 8" J. Pine N60W 49.30 8" J. Pine S54W 64.13 10" J. Pine S84E 86.36	D-5 P. Pole S28E 37.73 6" J. Pine N38W 54.89 14" J. Pine S22W 102.72
E-4 8" J. Pine S36W 48.40 6" J. Pine N36E 57.05 10" J. Pine S72E 62.25	E-5 8" J. Pine S50W 61.86 6" J. Pine S32E 57.65 6" J. Pine N38W 73.98	F-3 12" B. Oak N42W 51.24 14" B. Oak S42W 32.98 14" W. Oak S70E 57.92 (O.B.T.)
F-5 12" B. Oak S24W 55.38 6" B. Oak S48E 56.18	6" J. Pine N18E 74.52	


SIGNED BY Clinton E. Cole DATE Dec 28 1973

SURVEYOR'S MICHIGAN REGISTRATION NO. 17615

FOR STATE AND UNITED STATES AGENCIES:

SIGNED BY _____ DATE _____

APPROVED AND SIGNED BY _____ DATE _____

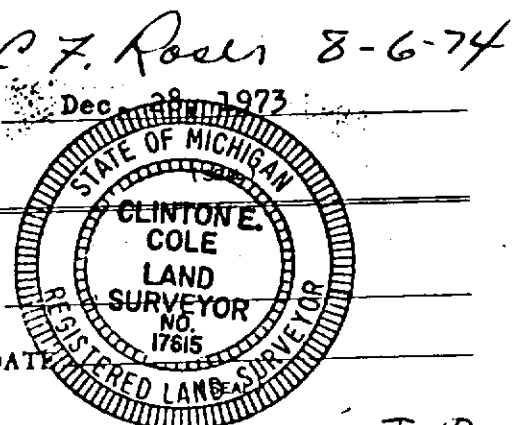

C. F. Roser 8-6-74
NORTH NEWKIRK TWP.
LAKE COUNTY

SURVEYOR'S MICHIGAN REGISTRATION NO. _____