

# LAND CORNER RECORDATION CERTIFICATE

## FILING REQUIREMENT OF ACT 74, MICH. P.A.1970

FOR CORNERS OF --:	LOCATED IN --:	CORNER CODE NUMBER
1. PUBLIC LAND SURVEY _____	T. 20 <span style="border: 1px solid black; border-radius: 50%; padding: 2px;">N.</span> R. 12 <span style="border: 1px solid black; border-radius: 50%; padding: 2px;">W.</span>	E-6
2. PROPERTY CONTROLLING IN SECTION 17 _____	T. 20 <span style="border: 1px solid black; border-radius: 50%; padding: 2px;">N.</span> R. 12 <span style="border: 1px solid black; border-radius: 50%; padding: 2px;">W.</span>	7; 14; 16
3. MISCELLANEOUS PROPERTY IN SECTION _____	T. _____ S. R. _____ E. W.	
4. LOT NO. _____, RECORDED PLAT _____		
5. PRIVATE CLAIMS _____		

REGISTER OF DEEDS STAMP AND FILING NUMBER

I, Carl F. Roser do hereby certify that under requirements of P.A. 74, Michigan P.A. of 1970, the corner points mentioned in lines 1 and 2 above (identified with circles on index code diagram - over) were, in a field survey on July 24, 1974, established, re-established, monumented, re-monumented, recovered or restored as expressed below and in conformance with regulations and rules therefore as required in the current manual of survey instructions of the United States Department of the Interior, Bureau of Land Management or by a decree of a court of law. Furthermore, that the corner points mentioned in lines 3, 4 and 5 above were, in a field survey on \_\_\_\_\_ 19\_\_\_\_, found, recovered, restored, established or re-established as expressed below and in conformance with the rules of the Michigan State Board of Registration for Land Surveyors or, by a Decree of a Court of law:

**A. Description of original monument and accessories and/or subsequent restoration:**

C. (continued)

16

Set 1"x30" pipe & cedar post  
w/loc. tag

10" Aspen	S35°E	38.8
15" J. Pine	S55°W	117.0

**B. Description of corner evidence found and/or method applied in restoring or re-establishing corner:**


- E-6 Established corner equidistant between section corners to N & S and 33' east of old fence remains to north.
- 7 Established corner per standard B.L.M. instructions.
- 14 Established corner per standard B.L.M. instructions.
- 16 Established corner per standard B.L.M. instructions.

**C. Description of monument for corner and accessories established to perpetuate locating the position of the corner:**

E-6	7	14
Set DNR monument & cedar post	Set 1"x30" pipe & cedar post	Set 1"x4½" pipe & cedar post
8" J. Pine S83°E 26.3	w/loc. tag	w/loc. tag
9" J. Pine S57°W 27.7	12" J. Pine N50°E 17.0	8" Maple N45°W 64.3
3" Maple S78°W 8.7	4" W. Pine S42°E 35.7	14" R. Pine N25°E 104.8
Fence remains E'ly Due S 95'±	N-S Fence remains Due W 33'	N-S fence remains
	Center N-S trail road	Due W 58'±
	Due W 13'	E-W fence remains
		Due S 114'±

SIGNED BY Carl F. Roser DATE 8/21/74

SURVEYOR'S MICHIGAN REGISTRATION NO. 12028

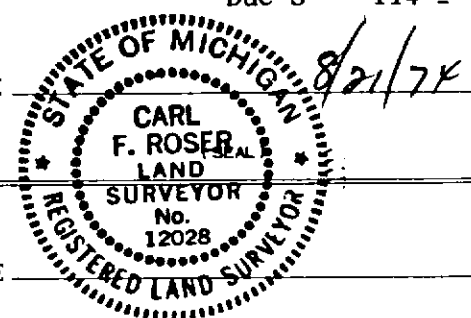

FOR STATE AND UNITED STATES AGENCIES:

SIGNED BY \_\_\_\_\_ DATE \_\_\_\_\_  
CHIEF OF SURVEY PARTY

APPROVED AND SIGNED BY \_\_\_\_\_ DATE \_\_\_\_\_  
MICHIGAN REGISTERED LAND SURVEYOR (SEAL)

SURVEYOR'S MICHIGAN REGISTRATION NO. \_\_\_\_\_ NORTH NEWKIRK TOWNSHIP  
LAKE COUNTY