

LAND CORNER RECORDATION CERTIFICATE

FILING REQUIREMENT OF ACT 74, MICH. P.A.1970

FOR CORNERS OF--:	LOCATED IN--:	CORNER CODE NUMBER
1. PUBLIC LAND SURVEY	T. 20 ^{N.} <input checked="" type="radio"/> , R. 12 ^{W.} <input checked="" type="radio"/>	E-1; E-2; E-3
2. PROPERTY CONTROLLING IN SECTION	T. _____, S. _____, R. _____, E. _____, W. _____	_____
3. MISCELLANEOUS PROPERTY IN SECTION	T. _____, S. _____, R. _____, E. _____, W. _____	_____
4. LOT NO. _____, RECORDED PLAT _____		
5. PRIVATE CLAIMS _____		

REGISTER OF DEEDS STAMP AND FILING NUMBER _____

I, Carl F. Roser do hereby certify that under requirements of P.A. 74, Michigan P.A. of 1970, the corner points mentioned in lines 1 and 2 above (identified with circles on index code diagram - over) were, in a field survey on July 11, 1974, established, re-established, monumented, re-monumented, recovered or restored as expressed below and in conformance with regulations and rules therefore as required in the current manual of survey instructions of the United States Department of the Interior, Bureau of Land Management or by a decree of a court of law. Furthermore, that the corner points mentioned in lines 3, 4 and 5 above were, in a field survey on _____ 19____, found, recovered, restored, established or re-established as expressed below and in conformance with the rules of the Michigan State Board of Registration for Land Surveyors or, by a Decree of a Court of law:

A. Description of original monument and accessories and/or subsequent restoration:


B. Description of corner evidence found and/or method applied in restoring or re-establishing corner:

- E-1 Recovered U.S.F.S. corner from witnesses. Corner falls in road intersection to W & S.
- E-2 Reestablished corner per standard B.L.M. instructions.
- E-3 Recovered 1/2" rerod at intersection of dirt roads N-S-E-W, as established by R.L.S. Clint Cole.

C. Description of monument for corner and accessories established to perpetuate locating the position of the corner:

E-1	E-2	E-3
Found pipe & added 1"x3' pipe (buried)	Set DNR mon. in center of N-S dirt road	Found 1/2" ref. bar (buried)
8" W. Oak S65°E 51.22	5" J. Pine N40°E 33.6	6" J. Pine N40°E 54.70
8" W. Oak S72°W 99.88	8" B. Oak N88°E 57.0	8" J. Pine N36°W 68.30
Post w/loc. tag S45°W 46.7	6" B. Oak S15°E 74.7	10" B. Oak S32°E 74.75
	Set cedar post Due E 16.5	Set cedar post w/loc. tag S45°W 50

SIGNED BY Carl F. Roser SURVEYOR'S MICHIGAN REGISTRATION NO. 12028

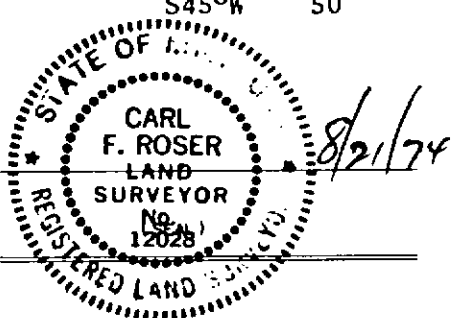

FOR STATE AND UNITED STATES AGENCIES:
 SIGNED BY _____ DATE _____
CHIEF OF SURVEY PARTY
 APPROVED AND SIGNED BY _____ DATE _____
MICHIGAN REGISTERED LAND SURVEYOR (SEAL)

SURVEYOR'S MICHIGAN REGISTRATION NO. _____ NORTH NEWKIRK TOWNSHIP
 LAKE COUNTY