

MAY 18 1998

LIBER 004 PAGE 0133

SECTION

LAND CORNER RECORDATION CERTIFICATE  
Filing Requirement of Act 74, Mich. P.A. 1970

For corners in

_____ Lake _____ (County)	Located In:	Corner Code #
1. Public Land Survey	T 20N R 12W T 20N R 13W T _____ R _____ T _____ R _____	A-5 ✓ M-5
2. Property Controlling in Section	S _____ T _____ R _____ S _____ T _____ R _____	_____
3. Miscellaneous Property in Sec.	S _____ T _____ R _____ S _____ T _____ R _____	_____

REGISTER OF DEEDS  
APR 14 3 05 PM '98  
RECORDED  
LAKE COUNTY, MI.  
Register of Deeds Stamp & File Number

4. Lot No. \_\_\_\_\_, Recorded Plat \_\_\_\_\_  
5. Private Claims \_\_\_\_\_

I, Robert L. Wetherell, in a field survey on March 2, 1998 do hereby state that under requirements of P.A. 74, Michigan P.A. of 1970, the corner points mentioned in lines 1 and 2 above were in conformance with regulations and rules therefore as required in the current manual of survey instructions of the United States Department of the Interior, Bureau of Land Management or by a decree of a Court of Law and /or that the corner points mentioned in lines 3, 4 and 5 above were in conformance with the rules of the Michigan Board of Land Surveyors or by a Decree of a Court of Law, established, re-established, monumented, recovered, found as expressed below:

	A	B	C	D	E	F	G	H	I	J	K	L	M
1													
2	6		5		4		3		2		1		
3													
4	7		8		9		10		11		12		
5													
6	18		17		16		15		14		13		
7													
8	19		20		21		22		23		24		
9													
10	30		29		28		27		26		25		
11													
12	31		32		33		34		35		36		
13													

NOTE: Not more than 2 corners, all in the same town and range, may be recorded on this certificate.

A. Description of original monument and accessories and/or subsequent restoration:

- A-5 & M-5 - Sec. Cor. Common to Sec. 7 & 18, T20N, R12W & Sec. 12 & 13, T20N, R13W, Lake Co., Mi.
- |                             |   |                               |
|-----------------------------|---|-------------------------------|
| 1837 - J. Mullett, G.L.O.   | Undated County Survey Records (1910-1920) | Undated County Survey Records |
| #1 - 8" Pine N79°W 52 Links | #3 - 8" B. Oak N42°W 1.25 Chains          | 3/4" Iron                     |
| #2 - 8" Pine S43°W 44 Links | #4 - 8" B. Oak S70°E 74 Links             | #5 - 10" J. Pine S30°W 80.70' |
|                             |   | #6 - U.S.G.S. BM N43°W 40.63' |
|                             |   | #7 - 16" Oak N53°E 60.72'     |
|                             |   | #8 - 6" J. Pine S26°E 68.89'  |

(SEE OVER FOR CONTINUATION OF "A")

B. Description of corner evidence found and/or method applied in restoring or reestablishing corner:

A-5 & M-5 - Sec. Cor. Common to Sec. 7 & 18, T20N, R12W & Sec. 12 & 13, T20N, R13W, Lake Co., Mi.

I found a 3/4" Linkage rod in center of roads East, West, South and 12 feet East of center of road to North. Corner checks well with accessories found.

Condition of the accessories are as follows: #1 Gone #2, Gone #3 Found stump, #4 Gone, #5 Found in good condition, #6 Found Broken, #7 Found stump, #8 Found in good condition, #9 Found in good condition, #10 Found in good condition, #11 Found in good condition, #12 Found in good condition, #13 Found in good condition,

C. Description of monument for corner and accessories established to perpetuate locating the position of the corner:

A-5 & M-5 - Sec. Cor. Common to Sec. 7 & 18, T20N, R12W & Sec. 12 & 13, T20N, R13W, Lake Co., Mi.


I replaced the 3/4" Linkage Rod with a 3/4" x 24" re-bar and Lake County Brass Cap, and is accepted as a careful and faithful re-establishment of the position of the original corner.

- G. Pole S31°W 71.08' (PK nail in E. side) #13
- G. Pole N25°E 35.13' (PK nail in S.W. side) #11
- G. Pole N43°W 46.11' (Spike in S.W. side) #10
- 12" J. Pine S25°E 70.18' (Spike in S.W. side) #8
- 6" B. Oak N39°W 85.82' (60d spike in S. side)

RATIFIED BY THE LAKE CO. PEER REVIEW GROUP  
IN ACCORDANCE WITH P.A. 345  
CHAIRMAN R.R.W.  
DATE 4-9-98

Signed by Robert L. Wetherell  
Surveyor's Michigan License No. 24624

Date 4-14-98

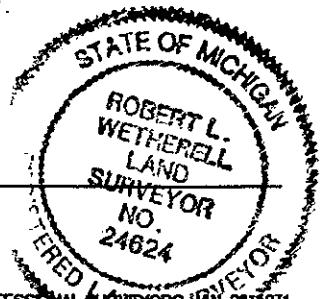

SURVEY &  
REMONUMENTATION

MAY 18 1998

LIBER 004 PAGE 0134

SECTION

CONTINUATION OF "A" - DESCRIPTION OF ORIGINAL MONUMENT AND ACCESSORIES AND/OR SUBSEQUENT RESTORATION:

1964 - George Blass, LS 5489

1" Iron Pipe

#7 - 18" B. Oak N52°E 60.75'

#9 - 6" J. Pine S58°W 93.73'

#8 - 8" J. Pine S27°E 69.96'

#6 - U.S.G.S. Monument N43°W 40.65'

1994 - Carl Kiiskila, LS 33981

L.C.R.C. - Liber 04, Pg. 11.

Found 3/4" Pipe

#10 - P.K. Nail in P. Pole N45°W 46.27'

#11 - P.K. Nail in G. Pole N25°E 35.05'

#12 - 13" J. Pine S25°E 70.30'

#13 - P.K. Nail in G. Pole S30°W 71.15'