LAND CORNER RECORDATION CERTIFICATE

Filing Requirement of Act 74, Mich. P.A. 1970

LIBER 003 PAGE 0275

For corners in Lake (County)

	Located In:		Corner Code #
	20N	12W	H-7
1. Public Land Survey	T ____	R ____	____
	T ____	R ____	____
	T ____	R ____	____
	T ____	R ____	____
2. Property Controlling	S ____ T ____	R ____	____
in Section	S ____ T ____	R ____	____
3. Miscellaneous	S ____ T ____	R ____	____
Property in Sec.	S ____ T ____	R ____	____

STATE OF MICHIGAN
COUNTY OF LAKE
RECORDED Nov 14 DAY OF 19 94 A.D. at O'Clock 11:30 A M.
Lucinda K. Dickow REGISTER OF DEEDS

Register of Deeds Stamp & File Number

4. Lot No. _____ , Recorded Plat _____
5. Private Claims _____

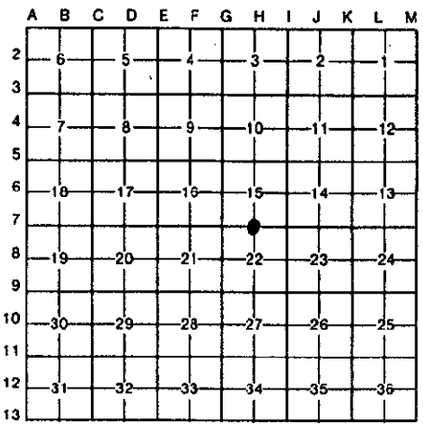

I, Robert L. Wetherell, in a field survey on October 27, 19 94, do hereby certify that under requirements of P.A. 74, Michigan P.A. of 1970, the corner points mentioned in lines 1 and 2 above were in conformance with regulations and rules therefore as required in the current manual of survey instructions of the United States Department of the Interior, Bureau of Land Management or by a decree of a Court of Law and/or that the corner points mentioned in lines 3, 4 and 5 above were in conformance with the rules of the Michigan Board of Land Surveyors or by a Decree of a Court of Law; established, re-established, monumented, re-monumented, recovered, found as expressed below:

NOTE: Not more than 4 corners, all in the same town and range, may be recorded on this certificate.

A. Description of original monument and accessories and/or subsequent restoration:

H-7 - 1/4 Corner common to Sections 15 and 22, T20N, R12W, North Newkirk Twp., Lake Co., Mi.

1838 - Sylvester Sibley, D.S., G.L.O.
#1 - 10" Beech N40-1/2°E 14 Links
#2 - 5" Beech S37-1/2°W 24 Links

1913 - George Johnson, Lake Co. Surveyor
#3 - 14" W. Pine Stump S15°W 33 feet
Reported distance of 2600.4' to S.E. cor. of Section 15.

1974 - Carl Roser, L.S. 12028
(D.N.R. Alum. capped pipe mon.)
(Set in fence line)
#4 - 14" Maple S15°W 88.1'
#5 - 20" W. Oak N70°E 55.5'
L.C.R.C. recorded in Liber 02, Page 229. Measured 2602.3' to S.E. cor. of Sec. 15 & 2602.0' to S.W. cor. of Sec. 15.

B. Description of corner evidence found and/or method applied in restoring or reestablishing corner.

H-7 - 1/4 Corner common to Sections 15 and 22, T20N, R12W, North Newkirk Twp., Lake Co., Mi.

Found aluminium capped D.N.R. Monument in fence line North and South and West (down). Condition of accessories are as follows: #1 gone, #2 Gone, #3 gone, #4 Found in good condition, #5 Found in good condition.

RATIFIED BY THE LAKE CO. PEER REVIEW GROUP
IN ACCORDANCE WITH P.A. 345
CHAIRMAN G. L. W.
DATE 11/8/94

C. Description of monument for corner and accessories established to perpetuate locating the position of the corner:

H-7 - 1/4 Corner common to Sections 15 and 22, T20N, R12W, North Newkirk Twp., Lake Co., Mi.

I accepted the D.N.R. Monument as a substantial monument for the corner, and is accepted as a careful and faithful re-establishment of the position of the original corner.

16" Maple S18°W 88.53' (60d spike in E. side of tree) (#4)
22" W. Oak N74°E 56.60' (60d spike in S. side of tree) (#5)
12" W. Oak N58°W 104.15' (60d spike in N. side of tree)
12" W. Oak S71°W 65.57' (60d spike in S. side of tree)

STATE OF MICHIGAN
ROBERT L. WETHERELL
LAND SURVEYOR
NO. 24624
REGISTERED LAND SURVEYOR

Signed by Robert L. Wetherell Date 11/9/94

Surveyor's Michigan License No. 24624

FORM APPROVED BY MICHIGAN STATE BOARD OF LAND SURVEYORS, JAN. 28, 1971
REVISED MAY 14, 1975
REVISED JAN., 1983