SURVEY
REMONU
MAY 1 8 1997
COM

LAND CORNER RECORDATION CERTIFICATE

Filing Requirement of Act 74, Mich. P.A. 1970

For corners in Lake (County)

	Located In:		Corner Code ##
	20N	12W	H-9
1. Public Land Survey	T ____	R ____	
	T ____	R ____	
	T ____	R ____	
	T ____	R ____	
2. Property Controlling	S ____ T ____	R ____	
in Section	S ____ T ____	R ____	
3. Miscellaneous	S ____ T ____	R ____	
Property in Sec.	S ____ T ____	R ____	

LIBER 003 PAGE 0367

RECORDED LAKE COUNTY, MI.
SEP 12 3 11 PM '96
REGISTER OF DEEDS

Register of Deeds Stamp & File Number

4. Lot No. _____, Recorded Plat _____
5. Private Claims _____

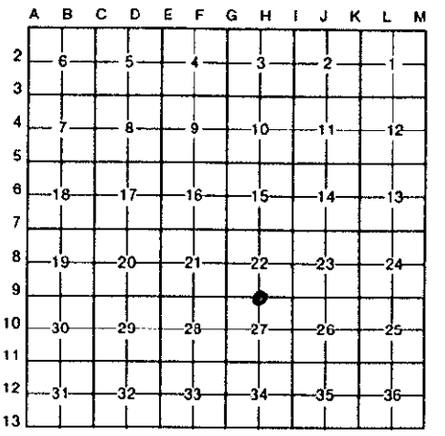

I, Robert L. Wetherell, in a field survey on March 7, 19 96, do hereby certify that under requirements of P.A. 74, Michigan P.A. of 1970, the corner points mentioned in lines 1 and 2 above were in conformance with regulations and rules therefore as required in the current manual of survey instructions of the United States Department of the Interior, Bureau of Land Management or by a decree of a Court of Law and/or that the corner points mentioned in lines 3, 4 and 5 above were in conformance with the rules of the Michigan Board of Land Surveyors or by a Decree of a Court of Law; established, re-established, monumented, re-monumented, recovered, found as expressed below:

NOTE: Not more than 4 corners, all in the same town and range, may be recorded on this certificate.

A. Description of original monument and accessories and/or subsequent restoration:

H-9 - Section corner common to Sections 22 and 27, T20N, R12W, North Newkirk Twp., Lake Co., Mi.

1838 - S. Sibley, G.L.O.
#1 - 22" Sugar N86°W 5 Links
#2 - 20" Beech S80-1/2°E 26 Links

Undated - George Johnson (1920's)
2" Pipe 4' Long

1978 - Clinton E. Cole, LS 17615
1-1/2" Pipe
#3 - 18" Ash S57°E 13.27'
#4 - 10" Maple S86°W 13.54'
#5 - 4" Oak N8°E 27.31'

B. Description of corner evidence found and/or method applied in restoring or reestablishing corner:

H-9 - Section corner common to Sections 22 and 27, T20N, R12W, North Newkirk Twp., Lake Co., Mi.

I found a 2 inch pipe in an East and West fence, 14 feet West of partial fence running South. Condition of Accessories are as follows: #1 Gone, #2 Gone, #3 Gone, #4 Found dead at S86°E not S86°W, #5 Found in good condition.

RATIFIED BY THE LAKE CO. PEER REVIEW GROUP
IN ACCORDANCE WITH P.A. 345
CHAIRMAN R.K.W.
DATE 8-27-96

C. Description of monument for corner and accessories established to perpetuate locating the position of the corner:

H-9 - Section corner common to Sections 22 and 27, T20N, R12W, North Newkirk Twp., Lake Co., Mi.

I drove a 3/4" x 24" re-bar with Lake County Brass Cap inside of the found 2 inch pipe, and is accepted as a careful and faithful re-establishment of the position of the original corner.

7" Oak N9°E 27.30' (found nail in W. side) #5
8" Tw. R. Oak N30°E 27.41' (60d spike in W. side)
7" Maple N65°E 40.49' (60d spike in N.W. side)
7" Tw. Beech S66°E 35.89' (60d spike in N. side)
12" R. Oak S86°W 26.36' (60d spike in S. side)

Signed by Robert L. Wetherell Date August 28, 1996

Surveyor's Michigan License No. 24624

STATE OF MICHIGAN
ROBERT L. WETHERELL
LAND SURVEYOR
NO. 24624
REGISTERED SURVEYOR

FORM APPROVED BY MICHIGAN STATE BOARD OF LAND SURVEYORS JAN. 28, 1971
REVISED MAY 14, 1975
REVISED JAN., 1983