

**SURVEY &  
REMONUMENTATION**

DEC - 4 1999

**LAND CORNER RECORDATION CERTIFICATE**

FILING REQUIREMENT OF ACT 74, Mich. P.A. 1970

RECORDED  
LAKE COUNTY, MI  
LIBER 004 PAGE 0235

**SECTION**

For corners in Lake	Located in:	Corner Code#
1. Public Land Survey	T 20N	R 12W H-11
	T	R
	T	R
	T	R
2. Property Controlling in Section	T	R
	S T	R
3. Miscellaneous Property in Sec.	S T	R
	S T	R
4. Lot No. _____ Recorded Plat		
5. Private Claims		

DEC 9 9 59 AM '99

*Shelley Meyers*

REGISTER OF DEEDS

Register of Deeds Stamp & File Number

I, Robert L. Wetherell, in a field survey on October 7, 1999, do hereby certify that under requirements of P.A. 74, Michigan P.A. of 1970, the corner points mentioned in lines 1 and 2 above were in conformance with regulations and rules therefore as required in the current manual of survey instructions of the United States Department of the Interior, Bureau of Land Management or by decree of a Court of Law and/or that the corner points mentioned in lines 3, 4, and 5 above were in conformance with the rules of the Michigan Board of Land Surveyors or by a Decree of a Court of Law; established, re-established, monumented, re-monumented, recovered, found as expressed below:

	A	B	C	D	E	F	G	H	I	J	K	L	M
1													
2	6	5	4	3	2	1							
3													
4	7	8	9	10	11	12							
5													
6	18	17	16	15	14	13							
7													
8	19	20	21	22	23	24							
9													
10	30	29	28	27	26	25							
11													
12	31	32	33	34	35	36							
13													

**H-11 - 1/4 Corner common to Sections 27 & 34, T20N, R12W**

**A. Description of original monument and accessories and/or subsequent restoration:**

**1838 - S. Sibley, G.L.O.**  
#1 - 18" Beech S50°E 16 Links  
#2 - 22" Sugar N48°W 32 Links

**1974 - C. Roser - D.N.R.**  
L.C.R.C. - Liber 02, Pg. 226.  
Set D.N.R. Monument by single proportionate method.  
"No witnesses available, corner in hay field".

**1995 - R.L. Wetherell, LS 24624**  
D.N.R. Monument  
#3 - 8" Cherry N70°E 157.02'  
#4 - 18" Maple N9°E 393.28'  
#5 - S.W. cor. House Foundation N6°W 403.89'

**B. Description of corner evidence found and/or method applied in restoring of reestablishing corner:**

I found the D.N.R. Capped Pipe in hay field.


Condition of the accessories are as follows: #1 Gone, #2 Gone, #3 Found in good condition, #4 Found in good condition, #5 Found in good condition.

**C. Description of monument for corner and accessories established to perpetuate locating the position of the corner:**

I accepted the D.N.R. Capped Pipe as a substantial marker for the corner, and is accepted as a careful and faithful reestablishment of the position of the original corner.

8" Cherry N70°E 157.02' (60d spike in N. side) #3  
18" Maple N9°E 393.28' (60d spike in W. side) #4  
S.W. corner house foundation N6°W 403.89' (#5)  
S.W. corner pole bar S84°E 112.98'

RATIFIED BY THE LAKE CO. PEER REVIEW GROUP  
IN ACCORDANCE WITH P.A. 345  
CHAIRMAN *R.L.W.*  
DATE 10-19-99

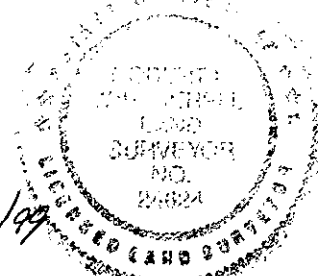

Signed by Robert L. Wetherell

Date 10/22/99

Surveyor's Michigan License No. 24624