

REMONI...

NOV 15 1994

LAND CORNER RECORDATION CERTIFICATE
Filing Requirement of Act 74, Mich. P.A. 1970

LIBER003 PAGE 0225

For corners in Lake COMMISSION

Table with columns: (County), Located In: (Town, Range, Section), Corner Code #. Includes entries for Public Land Survey, Property Controlling in Section, and Miscellaneous Property in Sec.

RECORDED LAKE COUNTY, MI.
REGISTER OF DEEDS
Oct 7 3 46 PM '94

Register of Deeds Stamp & File Number

4. Lot No. , Recorded Plat
5. Private Claims

Grid table with columns A-M and rows 2-13. A dot is marked at the intersection of column J and row 8.

I, Robert L. Wetherell, in a field survey on April 14, 1994, do hereby certify that under requirements of P.A. 74, Michigan P.A. of 1970, the corner points mentioned in lines 1 and 2 above were in conformance with regulations and rules therefore as required in the current manual of survey instructions of the United States Department of the Interior, Bureau of Land Management or by a decree of a Court of Law and/or that the corner points mentioned in lines 3, 4 and 5 above were in conformance with the rules of the Michigan Board of Land Surveyors or by a Decree of a Court of Law; established, re-established, monumented, re-monumented, recovered, found as expressed below:

NOTE: Not more than 4 corners, all in the same town and range, may be recorded on this certificate.

A. Description of original monument and accessories and/or subsequent restoration:

I-8 - (1/4 Corner common to Sections 22 and 23, T20N, R12W)

- 1838 - Sylvester Sibley, D.S., G.L.O.
#1 - 5" Maple S72°E 5 Links
#2 - 7" Y Pine N49°W 18 Links

- 1912 - George H. Johnson, County Surveyor
#3 - 24" W. Pine Stump S53°W 44-1/2 Links
"Corner of fence is OK"

B. Description of corner evidence found and/or method applied in restoring or reestablishing corner:

I-8 - (1/4 Corner common to Sections 22 and 23, T20N, R12W)

I found a 26" Pine stump/blaze (accessory #3), I measured N53°E 44.50 links from this stump (face) and found old corner fence post (down). I set the corner at this location. The corner is in line with an old North and South fence line and also one running West. Condition of the accessories are: #1 Gone, #2 Gone, #3 Found in good condition.

C. Description of monument for corner and accessories established to perpetuate locating the position of the corner:


I-8 - (1/4 Corner common to Sections 22 and 23, T20N, R12W)

I set a 3/4" x 24" re-bar with Lake County Brass Cap, and is accepted as a careful and faithful re-establishment of the position of the original corner.

- 11" R. Oak S55°E 60.54' (60d spike in Southwest side of tree)
6" R. Pine N72°W 40.08' (60d spike in South side of tree)
7" R. Oak N72°E 20.53' (60d spike in North side of tree)
9" W. Pine S41°W 55.43' (60d spike in East side of tree)

Signed by Robert L. Wetherell
24624
Surveyor's Michigan License No.

Date October 4, 1994

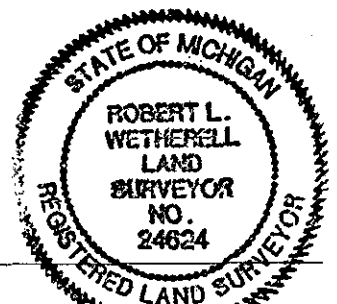

RATIFIED BY THE LAKE CO. PEER REVIEW GROUP
IN ACCORDANCE WITH P.A. 345
CHAIRMAN...