

MAY 1 9 1997

COMP

LAND CORNER RECORDATION CERTIFICATE
Filing Requirement of Act 74, Mich. P.A. 1970

For corners in

Table with columns: Lake (County), Located In: (20N, 12W), Corner Code # (I-9). Rows include Public Land Survey, Property Controlling in Section, and Miscellaneous Property in Sec.

LIBER 003 PAGE 0368

REGISTERED RECORDING LAKE COUNTY, MI. SEP 12 3 11 PM '96 REGISTER OF DEEDS Register of Deeds Stamp & File Number

4. Lot No. , Recorded Plat
5. Private Claims

Grid table with columns A-M and rows 2-13. A dot is marked at the intersection of column J and row 9.

I, Robert L. Wetherell, in a field survey on March 6, 1996 do hereby certify that under requirements of P.A. 74, Michigan P.A. of 1970, the corner points mentioned in lines 1 and 2 above were in conformance with regulations and rules therefore as required in the current manual of survey instructions of the United States Department of the Interior, Bureau of Land Management or by a decree of a Court of Law and/or that the corner points mentioned in lines 3, 4 and 5 above were in conformance with the rules of the Michigan Board of Land Surveyors or by a Decree of a Court of Law; established, re-established, monumented, re-monumented, recovered, found as expressed below:

NOTE: Not more than 4 corners, all in the same town and range, may be recorded on this certificate.

A. Description of original monument and accessories and/or subsequent restoration:

I-9 - Section corner common to Sections 22, 23, 26 & 27, T20N, R12W, North Newkirk Twp., Lake Co., Mi.

- 1838 - S. Sibley, G.L.O. 1912 - George Johnson, Co. Surveyor Co. Survey Records (undated)
#1 - 14" Maple S43°E 14 Links #3 - 38" Pine Stump S73°E 125 Links Railroad Rail 5' long
#2 - 7" Beech N45°E 31-1/2 Links "Stake along Fence" #4 - 3" Hickory S.W. 9'
#5 - 5" Lynn N.E. 31.0'

B. Description of corner evidence found and/or method applied in restoring or reestablishing corner:

I-9 - 1/4 Corner common to Sections 23 and 26, T20N, R12W, North Newkirk Twp., Lake Co., Mi.

I found a railroad rail in intersection of fences North, South and West. Also, I found an old pointed wood stake along side of iron. Condition of accessories are as follows: #1. Gone, #2. Gone, #3 Found Stump in good condition, #4 Found in good condition, #5. Found in good condition.


RATIFIED BY THE LAKE CO. PEER REVIEW GROUP IN ACCORDANCE WITH PA 345 CHAIRMAN DATE 8-27-96

C. Description of monument for corner and accessories established to perpetuate locating the position of the corner:

I-9 - 1/4 Corner common to Sections 23 and 26, T20N, R12W, North Newkirk Twp., Lake Co., Mi.

I accepted the Railroad Rail as a substantial monument for the corner, and is accepted as a careful and faithful re-establishment of the position of the original corner.

- 16" Hickory S12°W 9.13' (60d spike in E. side) O.B.T. #4
15" Basswood N22°E 30.78' (60d spike in N. side) O.B.T. #5
7" R. Oak S73°E 21.63' (60d spike in N. side)
8" Maple N51°W 45.15' (60d spike in S.W. side)

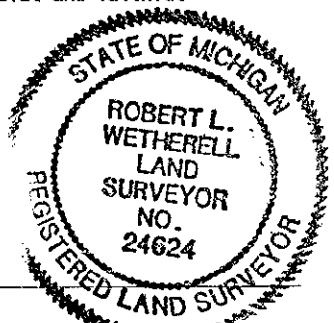

Signed by Robert L. Wetherell Date August 28, 1996
Surveyor's Michigan License No. 24624