

JAN 25 2001

SECTION LAND CORNER RECORDATION CERTIFICATE
 FILING REQUIREMENT OF ACT 74, Mich. P.A. 1970

For corners in Lake	Located in:	Corner Code#
1. Public Land Survey	T 20 N R 12 W	J-11
	T R	
	T R	
	T R	
2. Property Controlling in Section	S T R	
	S T R	
3. Miscellaneous Property in Sec.	S T R	
	S T R	
4. Lot No. Recorded Plat		
5. Private Claims		

RECORDED
 LAKE COUNTY, MI.
 LIBER 004 PAGE 0279

Dec 0 11 22 AM '00

Shelley Myers

REGISTER OF DEEDS

Register of Deeds Stamp & File Number

	A	B	C	D	E	F	G	H	I	J	K	L	M
1													
2	6	5	4	3	2	1							
3													
4	7	8	9	10	11	12							
5													
6	18	17	16	15	14	13							
7													
8	19	20	21	22	23	24							
9													
10	30	29	28	27	26	25							
11													
12	31	32	33	34	35	36							
13													

I, Robert L. Wetherell, in a field survey on July 3, 2000, do hereby certify that under requirements of P.A. 74, Michigan P.A. of 1970, the corner points mentioned in lines 1 and 2 above were in conformance with regulations and rules therefore as required in the current manual of survey instructions of the United States Department of the Interior, Bureau of Land Management or by decree of a Court of Law and/or that the corner points mentioned in lines 3, 4, and 5 above were in conformance with the rules of the Michigan Board of Land Surveyors or by a Decree Of a Court of Law; established, re-established, monumented, re-monumented, recovered, found as expressed below:

J-11 - 1/4 Corner common to Sections 26 & 35. T20N, R12W.

A. Description of original monument and accessories and/or subsequent restoration:

1838 - S. Sibley G.L.O.
 #1 - 22" Hemlock N13°E 9 Links
 #2 - 8" Beech S53°W 21 Links

No subsequent restoration of record since G.L.O.

B. Description of corner evidence found and/or method applied in restoring of reestablishing corner:


I did not recover any monument for this corner. I set the corner by doubling over line and distance from the Northwest corner of Section 35 to an old corner fence post at the West 1/16 corner on the North line of Section 35. From this post an old straight fence runs South and West. This makes the West 1/2 mile 2618.32 feet and the East 1/2 line 2637.2 feet. This position is 46.55 feet North and 9.39 feet West of a single proportionate position.

C. Description of monument for corner and accessories established to perpetuate locating the position of the corner:

I set a 3/4" x 24" rebar with Lake County Remon Cap, and is accepted as a careful and faithful reestablishment of the position of the original corner.

- 15" W. Oak N34°W 57.02' (60d spike W. side)
- 3" W. Oak N50°W 22.19' (60d spike S. side)
- 4" W. Oak N0°W 10.61' (60d spike W. side)
- 9" W. Pine N83°E 176.87' (60d spike N. side)

RATIFIED BY THE LAKE CO. PEER REVIEW GROUP
 IN ACCORDANCE WITH P.A. 345
 CHAIRMAN *RKW*
 DATE 12-5-2000

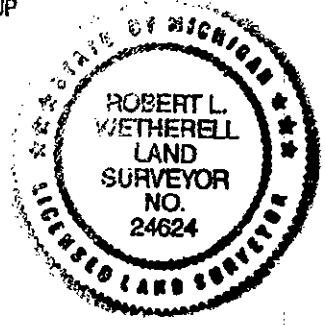

Signed by Robert L. Wetherell
 Surveyor's Michigan License No. 24624

Date December 6, 2000