

**LAND CORNER RECORDATION CERTIFICATE**  
**Filing Requirement of Act 74, Mich. P.A. 1970**

For corners in

Lake (County)	Located In:	Corner Code #/7
1. Public Land Survey	T <u>    </u> 20N R <u>    </u> 12W	K-9
	T <u>    </u> R <u>    </u>	
	T <u>    </u> R <u>    </u>	
	T <u>    </u> R <u>    </u>	
2. Property Controlling in Section	S <u>    </u> T <u>    </u> R <u>    </u>	
	S <u>    </u> T <u>    </u> R <u>    </u>	
3. Miscellaneous Property in Sec.	S <u>    </u> T <u>    </u> R <u>    </u>	
	S <u>    </u> T <u>    </u> R <u>    </u>	

RECORDED  
 LAKE COUNTY, MI.  
 SEP 12 3 11 PM '96  
 REGISTER OF DEEDS  
*Registrar M. Deane*

**LIBER 003 PAGE 0369**

Register of Deeds Stamp & File Number

4. Lot No. \_\_\_\_\_, Recorded Plat \_\_\_\_\_  
 5. Private Claims \_\_\_\_\_

I, Robert L. Wetherell, in a field survey on March 6, 1996, do hereby certify that under requirements of P.A. 74, Michigan P.A. of 1970, the corner points mentioned in lines 1 and 2 above were in conformance with regulations and rules therefore as required in the current manual of survey instructions of the United States Department of the Interior, Bureau of Land Management or by a decree of a Court of Law and/or that the corner points mentioned in lines 3, 4 and 5 above were in conformance with the rules of the Michigan Board of Land Surveyors or by a Decree of a Court of Law; established, re-established, monumented, re-monumented, recovered, found as expressed below:

A	B	C	D	E	F	G	H	I	J	K	L	M
2	6	5	4	3	2							
3												
4	7	8	9	10	11	12						
5												
6	18	17	16	15	14	13						
7												
8	19	20	21	22	23	24						
9												
10	30	29	28	27	26	25						
11												
12	31	32	33	34	35	36						
13												

**NOTE: Not more than 4 corners, all in the same town and range, may be recorded on this certificate.**

A. Description of original monument and accessories and/or subsequent restoration:

- K-9 - Section corner common to Sections 23, 24, 25 & 26, T20N, R12W, North Newkirk Twp., Lake Co., Mi.
- |                                     |  |
|-------------------------------------|--|
| <u>1838 - S. Sibley, G.L.O.</u>     | <u>1911- George Johnson, County Surveyor</u> |
| <u>#1 - 22" Pine S17°W 17 Links</u> | <u>#3 - 18" W. Pine Stump N30°W 47 Links</u> |
| <u>#2 - 20" Pine N40°E 30 Links</u> | <u>#4 - 24" W. Pine Stump S70°E 67 Links</u> |
|                                     | <u>#5 - W. Oak S21°W 80 Links</u>            |

B. Description of corner evidence found and/or method applied in restoring or reestablishing corner:

K-9 - Section corner common to Sections 23, 24, 25 & 26, T20N, R12W, North Newkirk Twp., Lake Co., Mi.

I set this corner from recovered accessories No. 3 and No. 4 above. Corner is 1.0' North of an old East and West fence. Accessories No. 1, No. 2 and No. 5 were not recovered.


RATIFIED BY THE LAKE CO. PEER REVIEW GROUP  
 IN ACCORDANCE WITH P.A. 345  
 CHAIRMAN R.L.W.  
 DATE 8-27-96

C. Description of monument for corner and accessories established to perpetuate locating the position of the corner:

K-9 - Section corner common to Sections 23, 24, 25 & 26, T20N, R12W, North Newkirk Twp., Lake Co., Mi.

I set a 3/4" x 24" re-bar with Lake County Brass Cap, and is accepted as a careful and faithful re-establishment of the position of the original corner.

6" W. Pine N83°E 34.50' (60d spike in N. side)  
 9" W. Pine N43°E 21.21' (60d spike in W. side)  
 6" W. Pine N18°W 8.36' (60d spike in S.W. side)  
 10" Maple S25°E 10.36' (60d spike in N.E. side)  
 18" Pine Stump N27°W 31.0' (O.B.T.)  
 24" Pine Stump S63°E 44.2' (O.B.T.)

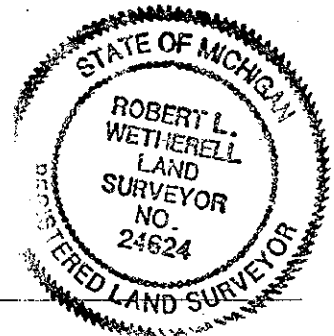

Signed by Robert L. Wetherell Date August 28, 1996  
 Surveyor's Michigan License No. 24624