

JAN 12 1996

COMMISSION

LAND CORNER RECORDATION CERTIFICATE

Filing Requirement of Act 74, Mich. P.A. 1970

LIBER003 PAGE 0330

For corners in

Lake (County)	Located In:		Corner Code #
	20N	12W	
1. Public Land Survey	T	R	K-10
	T	R	
	T	R	
	T	R	
2. Property Controlling in Section	S	T	R
	S	T	R
3. Miscellaneous Property in Sec.	S	T	R
	S	T	R

REGISTER OF DEEDS
 RECORDED
 LAKE COUNTY, MI.
 OCT 30 2 45 PM '95

Register of Deeds Stamp & File Number

- 4. Lot No. _____, Recorded Plat _____
- 5. Private Claims _____

I, Robert L. Wetherell, in a field survey on April 5, 1995, do hereby certify that under requirements of P.A. 74, Michigan P.A. of 1970, the corner points mentioned in lines 1 and 2 above were in conformance with regulations and rules therefore as required in the current manual of survey instructions of the United States Department of the Interior, Bureau of Land Management or by a decree of a Court of Law and/or that the corner points mentioned in lines 3, 4 and 5 above were in conformance with the rules of the Michigan Board of Land Surveyors or by a Decree of a Court of Law; established, re-established, monumented, re-monumented, recovered, found as expressed below:

A	B	C	D	E	F	G	H	I	J	K	L	M
2	6	5	4	3	2	1						
3												
4	7	8	9	10	11	12						
5												
6	18	17	16	15	14	13						
7												
8	19	20	21	22	23	24						
9												
10	30	29	28	27	26	25						
11												
12	31	32	33	34	35	36						
13												

NOTE: Not more than 4 corners, all in the same town and range, may be recorded on this certificate.

A. Description of original monument and accessories and/or subsequent restoration:

K-10 - 1/4 Corner common to Sections 25 and 26, T20N, R12W, Lake County, Mi.

1838 - S. Sibley (G.L.O.)

- #1 - 20" Pine S21°W 12 Links
- #2 - 20" Pine N46°E 22 Links

1911 - George Johnson, County Surveyor

- Found remains of old stake
- #1 - 20" Pine Stump S21°W 12 Links (O.B.T.)
- #3 - 20" Pine Stump S56°E 40 Links

B. Description of corner evidence found and/or method applied in restoring or reestablishing corner:

K-10 - 1/4 Corner common to Sections 25 and 26, T20N, R12W, Lake County, Mi.


I found accessory No. 1 with axe-markings still visible and accessory No. 3. I found the remains of accessory No. 2. I set the corner using the recorded distances to accessories No. 1 and No. 3.

C. Description of monument for corner and accessories established to perpetuate locating the position of the corner:

K-10 - 1/4 Corner common to Sections 25 and 26, T20N, R12W, Lake County, Mi.

I set a 3/4" x 24" re-bar with Lake County Brass Cap and is accepted as a careful and faithful perpetuation of the original corner.

- 10" W. Oak S78°E 66.42' (60d spike in N. side)
- 5" W. Pine S33°W 41.91' (60d spike in N.W. side)
- 7" W. Oak N2°W 23.28' (60d spike in W. side)
- 4" Beech N39°W 25.14' (60d spike in S.W. side)

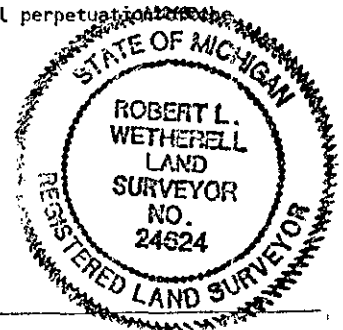

Signed by Robert L. Wetherell
24624

Date August 29, 1995

Surveyor's Michigan License No. _____

ATIFIED BY THE LAKE CO. PEER REVIEW GROUP
IN ACCORDANCE WITH P.A. 345
CHAIRMAN R.L.W.
DATE 8-29-95