

MAY 16 1957

COMMISSION

LAND CORNER RECORDATION CERTIFICATE
Filing Requirement of Act 74, Mich. P.A. 1970

RECORDED
LAKE COUNTY, MI.
SEP 12 9 12 PM '96
REGISTER OF DEEDS
James H. Dowd

For corners in
Lake

(County)	Located In:		Corner Code -# K-13
	20N	12W	
1. Public Land Survey	T _____	R _____	_____
	T _____	R _____	_____
	T _____	R _____	_____
	T _____	R _____	_____
2. Property Controlling in Section	S _____	T _____	R _____
	S _____	T _____	R _____
3. Miscellaneous Property in Sec.	S _____	T _____	R _____
	S _____	T _____	R _____

LIBER 003 PAGE 0376

Register of Deeds Stamp & File Number

- 4. Lot No. _____, Recorded Plat _____
- 5. Private Claims _____

Robert L. Wetherell August 19, 96

I, _____, in a field survey on _____, 19 _____, do hereby certify that under requirements of P.A. 74, Michigan P.A. of 1970, the corner points mentioned in lines 1 and 2 above were in conformance with regulations and rules therefore as required in the current manual of survey instructions of the United States Department of the Interior, Bureau of Land Management or by a decree of a Court of Law and/or that the corner points mentioned in lines 3, 4 and 5 above were in conformance with the rules of the Michigan Board of Land Surveyors or by a Decree of a Court of Law; established, re-established, monumented, re-monumented, recovered, found as expressed below:

	A	B	C	D	E	F	G	H	I	J	K	L	M
2	6		5		4		3		2		1		
3													
4	7		8		9		10		11		12		
5													
6	18		17		16		15		14		13		
7													
8	19		20		21		22		23		24		
9													
10	30		29		28		27		26		25		
11													
12	31		32		33		34		35		36		
13													

NOTE: Not more than 4 corners, all in the same town and range, may be recorded on this certificate.

A. Description of original monument and accessories and/or subsequent restoration:
K-13 - Section corner common to Sections 35 & 36, T20N, R12W, North Newkirk Twp., Lake Co., Mi.

- 1838 - J. Hodgson, G.L.O.
- #1 - 10" Hemlock N48°W 22 Links
- #2 - 24" Sugar N25°E 10 Links (Closing corner is 34 Links East)
- 1929 - George Johnson, County Surveyor
- #3 - 24" Basswood N81°E 56'
- #4 - 8" Elm N36°15'E 24.3'

B. Description of corner evidence found and/or method applied in restoring or reestablishing corner:
K-13 - Section corner common to Sections 35 & 36, T20N, R12W, North Newkirk Twp., Lake Co., Mi.

I found a 1-1/4" pipe 4 feet long in the centerline of an old road bed running North and 3 feet more or less North of centerline of road East and West. This pipe fits well (with G.L.O. record distance) to a found pipe for the closing Section corner (Sections 1 & 2, T19N, R12W)

None of the above accessories were recovered.


RATIFIED BY THE LAKE CO. PEER REVIEW GROUP
IN ACCORDANCE WITH P.A. 345
CHAIRMAN *A.L.W.*
DATE 8-27-94

C. Description of monument for corner and accessories established to perpetuate locating the position of the corner:

K-13 - Section corner common to Sections 35 & 36, T20N, R12W, North Newkirk Twp., Lake Co., Mi.

I replaced the 1-1/4" pipe with a 3/4" x 24" re-bar with a Lake County Brass Cap, and is accepted as a careful and faithful re-establishment of the position of the original corner.

- 12" Elm S62°W 57.11' (60d spike in N. side)
- 6" Tw. Elm N58°W 54.01' (60d spike in S. side)
- 12" R. Pine N10°W 83.38' (60d spike in E. side)
- 3/4" iron with Lake County Brass Cap - East 21.93' (Corner common to Sections 1 & 2, T19N, R12W)

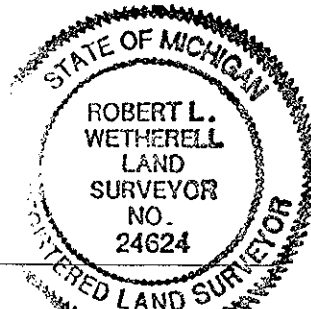

Signed by *Robert L. Wetherell* September 5, 1996
Surveyor's Michigan License No. 24624