

NOV 21 1997

COMMISSION

LAND CORNER RECORDATION CERTIFICATE
Filing Requirement of Act 74, Mich. P.A. 1970

RECORDED
LAKE COUNTY, MI.

LIBER 004 PAGE 0034

SEP 12 10 31 AM '97

Robert L. Wetherell
REGISTER OF DEEDS

For corners in

Lake (County)	Located In:	Corner Code #/
1. Public Land Survey	T 20N R 11W T 20N R 12W T _____ R _____ T _____ R _____	A-10 M-10 ✓
2. Property Controlling in Section	S _____ T _____ R _____ S _____ T _____ R _____	
3. Miscellaneous Property in Sec.	S _____ T _____ R _____ S _____ T _____ R _____	

Register of Deeds Stamp & File Number

- 4. Lot No. _____, Recorded Plat _____
- 5. Private Claims _____

Robert L. Wetherell July 3, 97

I, _____, in a field survey on _____, 19 _____, do hereby certify that under requirements of P.A. 74, Michigan P.A. of 1970, the corner points mentioned in lines 1 and 2 above were in conformance with regulations and rules therefore as required in the current manual of survey instructions of the United States Department of the Interior, Bureau of Land Management or by a decree of a Court of Law and/or that the corner points mentioned in lines 3, 4 and 5 above were in conformance with the rules of the Michigan Board of Land Surveyors or by a Decree of a Court of Law; established, re-established, monumented, re-monumented, recovered, found as expressed below:

	A	B	C	D	E	F	G	H	I	J	K	L	M
2	6	5	4	3	2	1							
3													
4	7	8	9	10	11	12							
5													
6	18	17	16	15	14	13							
7													
8	19	20	21	22	23	24							
9													
10	30	29	28	27	26	25							
11													
12	31	32	33	34	35	36							
13													

NOTE: Not more than 4 corners, all in the same town and range, may be recorded on this certificate.

A. Description of original monument and accessories and/or subsequent restoration:

A-10; M-10 - 1/4 Corner common to Section 30, T20N, R11W & Sec. 25, T20N, R12W, Lake Co., Mi.

- | | | |
|--|---|--|
| 1838 - John Hodgson, G.L.O.
#1 - 10" Hemlock N37°W 25 Links
#2 - 12" Beech S57°W 23 Links
1911-George Johnson, Co. Sur.
Stone for corner
#3 - 24" Pine stump S34-1/2°W 172 Links
#4 - 26" Pine stump N19°E 74-1/2 Links
Undated - Co. Survey Records: Cement Post - 3' long for corner. Same accessores as 1911 Johnson's | 1981 - Carl Roser, D.N.R.
L.C.R.C. Liber 02, Pg. 43.
"Found 3/8" rod and (3) Jim Fletcher's witnesses". Raised with 1"x18" Pipe.
#5 - 12" Maple S15°E 97.12'
#6 - 27" R. Oak S45°W 58.04'
#7 - Cedar Post - West 33.0' | 1995 - R. Wetherell, LS 24624
1" Pipe
#5 - 14" Maple S15°E 96.93'
#8 - Fence Post S82°E 32.72'
#9 - 16" Tw. W. Oak N15°E 144.41'
#10 - 5" R. Oak N81°W 41.32' |
|--|---|--|

B. Description of corner evidence found and/or method applied in restoring or reestablishing corner:

A-10; M-10 - 1/4 Corner common to Section 30, T20N, R11W & Sec. 25, T20N, R12W, Lake Co., Mi.

I found a 1" pipe directly over a 1/2" iron rod in the centerline of North and South road and in line with fence to the West.

Condition of the accessories are as follows: #1 Gone #2 Gone, #3 Gone, #4 Gone, #5 Found in good condition, #6 Found stump, #7 Found in good condition, #8 Found in good condition, #9 Found in good condition, #10 Found in good condition.

There is about a 4 foot cut for road construction in the area which probably destroyed the old stone.

WATIFIED BY THE LAKE CO. PEER REVIEW GROUP
IN ACCORDANCE WITH P.A. 345


CHAIRMAN 8-27-97
DATE R. L. W.

C. Description of monument for corner and accessories established to perpetuate locating the position of the corner:

A-10; M-10 - 1/4 Corner common to Section 30, T20N, R11W & Sec. 25, T20N, R12W, Lake Co., Mi.

I replaced the pipe and 1/2" rod with a 3/4" x 24" re-bar with Lake County Brass Cap, and is accepted as a careful and faithful re-establishment of the position of the original corner.

- 14" Maple S15°E 96.93' (60d spike in W. side) #5
- Fence Post S82°E 32.72' (60d spike in S. side) #8
- 16" Tw. W. Oak N15°E 144.41' (60d spike in W. side) #9
- 5" R. Oak N81°W 41.32' (60d spike in N. side) #10

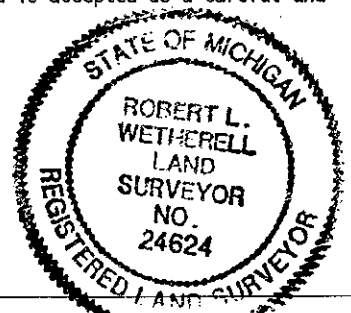

Signed by *Robert L. Wetherell*
24624

Date 8-27-97

Surveyor's Michigan License No. _____