

NOV 21 1997

RECORDED
LAKE COUNTY, MI.

COMMISSION

LAND CORNER RECORDATION CERTIFICATE
Filing Requirement of Act 74, Mich. P.A. 1970

LIBER 004 PAGE 0033

SEP 12 10 31 AM '97

For corners in

Lake (County)	Located In:	Corner Code #
1. Public Land Survey	T 20N R 11W T 20N R 12W T _____ R _____ T _____ R _____	A-11 M-11 ✓
2. Property Controlling in Section	S _____ T _____ R _____ S _____ T _____ R _____	
3. Miscellaneous Property in Sec.	S _____ T _____ R _____ S _____ T _____ R _____	

Charles H. Dechant
REGISTER OF DEEDS

Register of Deeds Stamp & File Number

- 4. Lot No. _____, Recorded Plat _____
- 5. Private Claims _____

	A	B	C	D	E	F	G	H	I	J	K	L	M
2	6		5		4		3		2		1		
3													
4	7		8		9		10		11		12		
5													
6	18		17		16		15		14		13		
7													
8	19		20		21		22		23		24		
9													
10	30		29		28		27		26		25		
11													
12	31		32		33		34		35		36		
13													

Robert L. Wetherell July 3, 97

I, _____, in a field survey on _____, 19 _____, do hereby certify that under requirements of P.A. 74, Michigan P.A. of 1970, the corner points mentioned in lines 1 and 2 above were in conformance with regulations and rules therefore as required in the current manual of survey instructions of the United States Department of the Interior, Bureau of Land Management or by a decree of a Court of Law and/or that the corner points mentioned in lines 3, 4 and 5 above were in conformance with the rules of the Michigan Board of Land Surveyors or by a Decree of a Court of Law; established, re-established, monumented, re-monumented, recovered, found as expressed below:

NOTE: Not more than 4 corners, all in the same town and range, may be recorded on this certificate.

A. Description of original monument and accessories and/or subsequent restoration:

A-11; M-11, - Sec. corner common to Sec. 30 & 31 T20N, R11W & Sec. 25 & 36, T20N, R12W, Lake Co., Mi.

1838 - John Hodgson, G.L.O.

#1 - 14" Pine S54°W 31 Links

#2 - 16" Pine N40° 40 Links

1905 - J.W. Nicholson, Co. Sur.

#3 30" W. Oak N17-1/2°E 1.75 Links

1911 - George Johnson, Co. Sur.

Iron Stake & Rocks

#4 - 14" W. Oak N18°E 176 Links

#5 - 24" Pine Stump N85°W 56 Links

(See over for continuation of "A")

B. Description of corner evidence found and/or method applied in restoring or reestablishing corner:

A-11; M-11, - Sec. corner common to Sec. 30 & 31 T20N, R11W & Sec. 25 & 36, T20N, R12W, Lake Co., Mi.

I found the 1/2" Capped Iron I set in 1995 in centerline of North and South road.

Condition of the accessories are as follows: #1 Gone, #2 Gone, #3 Gone, #4 Found remains of stump, #5 Found stump, #6 Gone, #7 Gone, #8 Found in good condition, #9 Found in good condition, #10 Found dead, #11 Found in good condition.

I measured 2634.86 feet North to the 1/4 corner and 2630.14 feet South to the 1/4 corner.

RATIFIED BY THE LAKE CO. PEER REVIEW GROUP
IN ACCORDANCE WITH P.A. 345

CHAIRMAN *R.L.W.*
DATE 8-27-97

C. Description of monument for corner and accessories established to perpetuate locating the position of the corner:

A-11; M-11, - Sec. corner common to Sec. 30 & 31 T20N, R11W & Sec. 25 & 36, T20N, R12W, Lake Co., Mi.


I replaced the 1/2" iron with a 3/4" x 24" re-bar and Lake County Brass Cap, and is accepted as a careful and faithful re-establishment of the position of the original corner.

8" Tw. B. Oak S45°E 50.13' (60d spike in N.E side) #8

16" W. Oak N53°E 47.80' (60d spike in N. side) #9

7" W. Pine S86°W 47.36' (60d spike in S. side) #10

6" W. Pine S31°W 90.40' (60d spike in E. side)

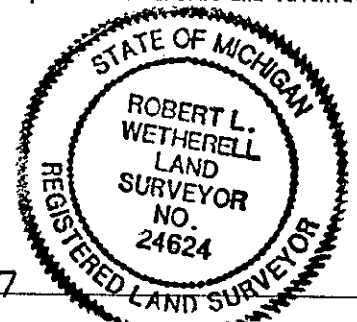

Signed by *Robert L. Wetherell*
24624

Date 8-27-97

Surveyor's Michigan License No. _____

A-33A

CONTINUATION OF "A" - DESCRIPTION OF ORIGINAL MONUMENT AND ACCESSORIES AND/OR SUBSEQUENT RESTORATION:

1950 - George Blass, LS 5489

Found 5/8" Rod

#6 - 8" Tw. W. Oak N39°W 37.9'

#7 - 12" W. Oak N47°W 46.8'

#8 - 14" Tw. B. Oak S47°E 49.7'

1995 - Robert L. Wetherell, LS 24624

L.C.R.C. - Liber 03, Page 286

Re-set corner from recovered

accessories by G. Johnson & G. Blass

#8 - 6" & 8" Tw. B. Oak S45°E 50.13' (O.B.T.)

#9 - 16" W. Oak N53°E 47.80'

#10 - 12" B. Oak S30°W 79.58'

#11 - 7" W. Pine S86°W 47.36'