

NOV 2 1 1987

COMM

RECORDED
LAKE COUNTY, MI.

LIBER 004 PAGE 0032
SEP 12 10 31 AM '97

LAND CORNER RECORDATION CERTIFICATE
Filing Requirement of Act 74, Mich. P.A. 1970

For corners in

Lake (County)	Located In:	Corner Code #
1. Public Land Survey	T 20N R 12W	M-12 ✓
	T 20N R 11W	A-12
	T _____ R _____	_____
	T _____ R _____	_____
	T _____ R _____	_____
2. Property Controlling in Section	S _____ T _____ R _____	_____
	S _____ T _____ R _____	_____
3. Miscellaneous Property in Sec.	S _____ T _____ R _____	_____
	S _____ T _____ R _____	_____

Robert L. Wetherell
REGISTER OF DEEDS

Register of Deeds Stamp & File Number

4. Lot No. _____, Recorded Plat _____
5. Private Claims _____

I, Robert L. Wetherell, in a field survey on July 3, 1997

do hereby certify that under requirements of P.A. 74, Michigan P.A. of 1970, the corner points mentioned in lines 1 and 2 above were in conformance with regulations and rules therefore as required in the current manual of survey instructions of the United States Department of the Interior, Bureau of Land Management or by a decree of a Court of Law and/or that the corner points mentioned in lines 3, 4 and 5 above were in conformance with the rules of the Michigan Board of Land Surveyors or by a Decree of a Court of Law; established, re-established, monumented, re-monumented, recovered, found as expressed below:

	A	B	C	D	E	F	G	H	I	J	K	L	M
2	6	5	4	3	2	1							
3													
4	7	8	9	10	11	12							
5													
6	18	17	16	15	14	13							
7													
8	19	20	21	22	23	24							
9													
10	30	29	28	27	26	25							
11													
12	31	32	33	34	35	36							
13													

NOTE: Not more than 4 corners, all in the same town and range, may be recorded on this certificate.

A. Description of original monument and accessories and/or subsequent restoration:

- M-12; A-12 - 1/4 Corner common to Sec. 36, T20N, R12W and Sec. 31, T20N, R11W, Lake Co., Mi.
 - 1838 - John Hodgson, G.L.O. #1 - 10" Hemlock N38°W 14 Links #2 - 8" Hemlock S58°W 20 Links
 - 1905 - J.W. Nicholson, Co. Sur. #3 - Pine Stump S38-1/2°E 51.5 Links (Equal distance between Sec. Corners)
 - 1993 - Robert L. Wetherell, LS 24624 Set 1/2" Iron in center of North and South road by doubling over the distance measured from the S.E. cor. of Sec. 36 to an old fence line running East at the S. 1/16 line. #4 - 6" W. Pine N80°E 47.20' #5 - 8" W. Pine S39°E 46.30' #6 - 6" Maple S20°W 77.88' #7 - 10" w. oak N46°W 49.8'

B. Description of corner evidence found and/or method applied in restoring or reestablishing corner:

M-12; A-12 - 1/4 Corner common to Sec. 36, T20N, R12W and Sec. 31, T20N, R11W, Lake Co., Mi.

I found the 1/2" Capped Iron I had set in 1993. I measured 2636.58 feet South to the Township corner and 2630.14 feet North to the Northeast corner of Section 36.

Condition of the accessories are as follows: #1 Gone #2 Gone, #3 Gone, #4 Found in good condition, #5 Found in good condition, #6 Found in good condition, #7 Found Stump.


RATIFIED BY THE LAKE CO. PEER REVIEW GROUP
IN ACCORDANCE WITH P.A. 345
CHAIRMAN *R.L.W.*
DATE *8-27-97*

C. Description of monument for corner and accessories established to perpetuate locating the position of the corner:

M-12; A-12 - 1/4 Corner common to Sec. 36, T20N, R12W and Sec. 31, T20N, R11W, Lake Co., Mi.

I replaced the 1/2" Capped Iron with a 3/4" x 24" re-bar with Lake County Brass Cap, and is accepted as a useful and faithful re-establishment of the position of the original corner.

6" W. Pine N80°E 47.20' (60d spike in N. side) #4
8" W. Pine S39°E 46.30' (60d spike in N. side) #5
6" Maple S20°W 77.88' (60d spike in E. side) #6
7" W. Pine N32°W 60.27' (60d spike in E. side)

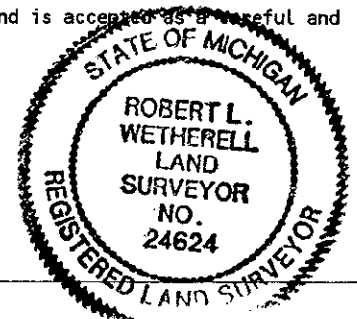

Signed by *Robert L. Wetherell* Date *8-27-97*
24624

Surveyor's Michigan License No. _____