

**LAND CORNER RECORDATION CERTIFICATE**  
Filing Requirement of Act 74, Mich. PA 1970

For Corners In:  
Lake \_\_\_\_\_ Located In \_\_\_\_\_ Corner Code # \_\_\_\_\_  
(County) \_\_\_\_\_

1. Public Land Survey T 20N R 12W E5  
T \_\_\_\_\_ R \_\_\_\_\_ \_\_\_\_\_  
2. Property Controlling S \_\_\_\_\_ T \_\_\_\_\_ R \_\_\_\_\_  
in Section S \_\_\_\_\_ T \_\_\_\_\_ R \_\_\_\_\_  
3. Miscellaneous S \_\_\_\_\_ T \_\_\_\_\_ R \_\_\_\_\_  
Property in Section S \_\_\_\_\_ T \_\_\_\_\_ R \_\_\_\_\_


4. Lot No: \_\_\_\_\_ Recorded Plat: \_\_\_\_\_

5. Private Claims: \_\_\_\_\_

I, Craig W. McVean, in a field survey on Apr. 2, 2009 do hereby state that under requirements of PA 74, Michigan PA of 1970, the corner points mentioned in lines 1 and 2 above were in conformance with regulations and rules therefore as required in the current manual of survey instructions of the United States Department of the Interior, Bureau of Land Management or by a decree of a Court of Law and/or that the corner points mentioned in lines 3, 4 and 5 above were in conformance with the rules of the Michigan Board of Land Surveyors or by a Decree of a Court of Law; established, re-established, monumented, recovered, found as expressed below:

**NOTE: Not more than 2 corners, all in the same town and range, may be recorded on this certificate.**

Register of Deeds Stamp & File Number

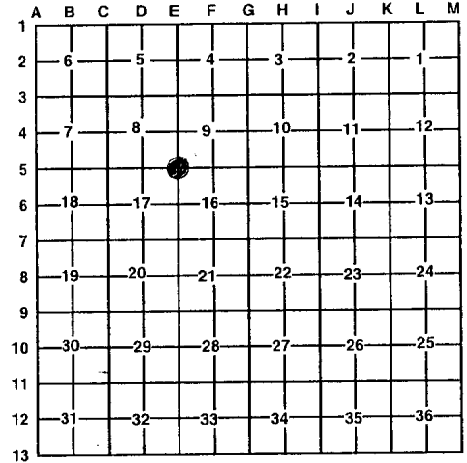

A. Description of original monument and accessories and/or subsequent restoration:

E5 – Section corner common to Sections 8, 9, 16 & 17.

- 1838 – GLO – S. Sibley – Set Post
  - 1) Pine 8" S4°E 55 L.
  - 2) Pine 8" N45°W 70 L.
- 1974 – LCRC L. 2, p. 179, C. Cole  
Fd. iron pin – set concrete mon.
  - 3) J. Pine S50°W 61.86'
  - 4) J. Pine S32°E 57.65'
  - 5) J. Pine N38°W 73.98'
- 1974 – LCRC L. 2, p. 179- C. F. Roser- Accepted C. Cole cor.
  - 6) Set Cedar post with loc. tag S45°W 33'

- 1976 – LCRC L. 2, p. 294, W. Ruddell. Found concrete monument
  - 4) 8" J. Pine SE 57.63'
  - 6) P. Pole (face) NW 42.95'
  - 7) DNR Post (face) SW 32.68'
- 1998 – LCRC L. 4, p. 138 – R. L. Wetherell. Fd. Cole 4" Conc. Mon. at intersection of road E, W & N.
  - 4) 7" J. Pine S26°E 57.67'
  - 3) 11" J. Pine S53°W 61.80'
  - 5) 10" J. Pine N36°W 73.95'
  - 8) 9" J. Pine N31°E 49.07'

B. Description of corner evidence found and/or method applied in restoring or re-establishing corner:

E5 – Section corner common to Sections 8, 9, 16 & 17 - Found 1/2" x 8" capped iron rod #24624 at surface of bit road, 14.5' east of centerline of gravel road north. Removed capped iron rod and found 1/2" iron in concrete monument down 1.0'. Condition of witnesses #1 & #2 – Gone; witnesses #3 & #4 – Good; #5 – Gone; #6 – New pole; #7 – Fallen; #8-Dead. Concrete monument is accepted as best available evidence of the position of the original corner.

C. Description of monument for corner and accessories established to perpetuate locating the position of the corner:

E5 – Placed monument box in bit. road over top of 1/2" iron in concrete monument  
S27°E 57.70' to found 60d nail at Blass tag in SW side 9' J. Pine (#4)  
S50°W 61.81' to found 60d nail at Blass tag in SE side 12" J. Pine (#3)  
N45°W 43.92' to set nail & tag in south side power pole  
N26°E 58.09' to set nail & tag in West side 9" Oak  
S60°W 38.00' to set nail & tag in reset Cedar post with location tag



Signed by: Craig W. McVean  
Surveyor's Michigan License No.: 39088

Date: 4/21/2009