

# LAND CORNER RECORDATION CERTIFICATE


Filing Requirement of Act 74, Mich. PA 1970

For Corners In:			
Lake _____	Located In _____	Corner Code # _____	
(County) _____			
1. Public Land Survey	T <u>20N</u> R <u>12W</u>	<u>F4</u>	
	T _____ R _____	_____	
2. Property Controlling in Section	S <u>9</u> T <u>20N</u> R <u>12W</u>	<u>CNS 1/64</u>	
	S _____ T _____ R _____	_____	
3. Miscellaneous Property in Section	S _____ T _____ R _____	_____	
	S _____ T _____ R _____	_____	
4. Lot No: _____	Recorded Plat: _____		
5. Private Claims: _____			

Register of Deeds Stamp & File Number

I, Craig W. McVean, in a field survey on March 26, 2009 do hereby state that under requirements of PA 74, Michigan PA of 1970, the corner points mentioned in lines 1 and 2 above were in conformance with regulations and rules therefore as required in the current manual of survey instructions of the United States Department of the Interior, Bureau of Land Management or by a decree of a Court of Law and/or that the corner points mentioned in lines 3, 4 and 5 above were in conformance with the rules of the Michigan Board of Land Surveyors or by a Decree of a Court of Law; established, re-established, monumented, recovered, found as expressed below:

**NOTE: Not more than 2 corners, all in the same town and range, may be recorded on this certificate.**

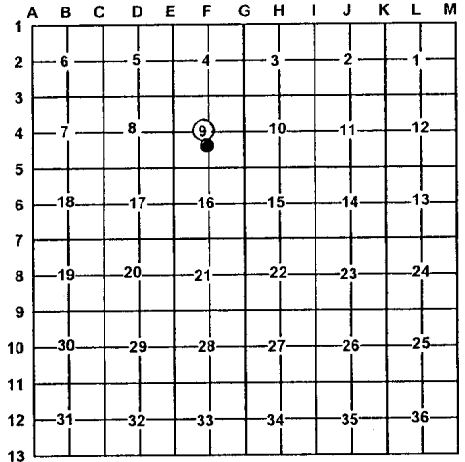

**A. Description of original monument and accessories and/or subsequent restoration:**

<p><u>F4 - 1977</u> - LCRC - L. 2, p. 292 &amp; Rec. Survey L. 2, p. 15 -                  W. B. Ruddell - Fd. Blacksmith Tong surrounded by stones and old DNR wood post marker post down and lying beside.                  1) Spike &amp; Blaze in 18" - 10" - 10" Tri-Oak N. 27.6'                  2) Old DNR Marker post NW 0.5'                  3) Spike &amp; Blaze in 12" Maple NW 15.33'                  4) Blaze in 18" Oak SE 10.77</p>	<p><u>CNS 1/64</u> - None</p>
<p>- <u>1998</u> - Unrecorded Survey - Wetherell Land Surveying File No. 8521-98; R. L. Wetherell - Found iron.</p>	

**B. Description of corner evidence found and/or method applied in restoring or re-establishing corner:**

<p><u>F4</u> - C ¼ Cor. Sec. 9 - Found 1.75' Long upright Blacksmith Tong with Couple of stones around per Ruddell and used by Wetherell. The calculated intersection of ¼ lines is S62°09'W 5.44' from Tong. Witness #1 &amp; 3 are good, #2 is gone, #4 is dead. Blacksmith Tong accepted as the best available evidence of the position of the corner.</p>	<p><u>CNS 1/64</u> - Cor. Sec. 9 - being the SE Cor. of the N ½ of the N ½ of the SW ¼, Sec. 9 - Set 2" Alum. Cap on 5/8" x 34" rebar per Standard BLM procedure.</p>
---	---

**C. Description of monument for corner and accessories established to perpetuate locating the position of the corner:**

<p><u>F4</u> - Replaced Blacksmith Tong with Stamped 3 ½" State of Michigan Alum. Cap on 1" x 3' long galv. iron pipe. Added Ring of Stones. Reset Tong alongside base of monument as memorial.                  N3°W 28.51' to set N &amp; T in W. side Tw. 20" &amp; 12" Oak (#1)                  S6°E 46.88' to set N &amp; T in E. side 15" W. Oak                  S66°E 73.00' to set N &amp; T in E. side Tw. 14" W. Oak                  N55°W 15.79' to set N &amp; T in W. side Tw. 15" R. Maple (#3)                  Set Blue Carsonite Post with loc. tag 1' SW</p>	<p><u>CNS 1/64</u> - Stamped 2" Alum. Cap on 5/8" x 34" rebar.                  Set Blue Carsonite Post with loc. tag 1' NE                  N75°E 45.96' to set N &amp; T in S. side 11" J. Pine                  S15°W 5.71' to set N &amp; T in E. side 10" Oak                  N79°W 11.80' to set N &amp; T in S. side 8" Oak                  N5°W 29.72' to set N &amp; T in E. side 8" Oak</p>
---	---

Signed by: Craig W. McVean  
 Surveyor's Michigan License No.: 39088

Date: 4/21/2009

