


LAND CORNER RECORDATION CERTIFICATE
Filing Requirement of Act 74, Mich. PA 1970

For Corners In: Lake _____ (County)	Located In	Corner Code #
1. Public Land Survey	T _____ R _____	_____
	T _____ R _____	_____
2. Property Controlling in Section	S 9 T 20N R 12W	5
	S 9 T 20N R 12W	6
3. Miscellaneous Property in Section	S _____ T _____ R _____	_____
	S _____ T _____ R _____	_____
4. Lot No: _____	Recorded Plat: _____	
5. Private Claims: _____		

Register of Deeds Stamp & File Number

I, Craig W. McVean, in a field survey on March 26, 2009 do hereby state that under requirements of PA 74, Michigan PA of 1970, the corner points mentioned in lines 1 and 2 above were in conformance with regulations and rules therefore as required in the current manual of survey instructions of the United States Department of the Interior, Bureau of Land Management or by a decree of a Court of Law and/or that the corner points mentioned in lines 3, 4 and 5 above were in conformance with the rules of the Michigan Board of Land Surveyors or by a Decree of a Court of Law; established, re-established, monumented, recovered, found as expressed below:

NOTE: Not more than 2 corners, all in the same town and range, may be recorded on this certificate.

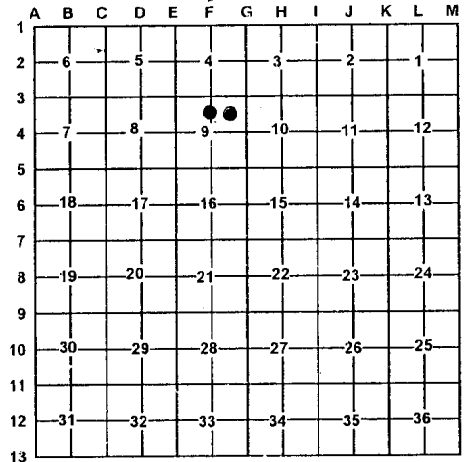

A. Description of original monument and accessories and/or subsequent restoration:

5 - 1977 - LCRC - L. 2, p. 293 & Rec. Survey L. 2, p. 15 - W. B. Ruddell - Set 3/4" x pipe 18" long capped with yellow plastic cap with 30" Long hardwood stake beside.

6 - 1977 - LCRC - L. 2, p. 293 & Rec. Survey L. 2, p. 15 - W. B. Ruddell - Set 3/4" x pipe 18" long capped with yellow plastic cap with 30" long hardwood stake beside.

B. Description of corner evidence found and/or method applied in restoring or re-establishing corner:

5 - CN 1/16 Cor. Sec. 9 - Fd. 3/4" I.D. iron pipe per Ruddell. 3/4" iron pipe accepted as the best available evidence of the position of the corner.

6 - NE 1/16 Cor. Sec. 9 - Fd. 3/4" I.D. iron pipe per Ruddell. 3/4" iron pipe accepted as the best available evidence of the position of the corner.

C. Description of monument for corner and accessories established to perpetuate locating the position of the corner:

5 - 3/4" iron pipe
Set Blue Carsonite Post with loc. tag 1' NW
N54°E 38.23' to set N & T in SE side 16" Tw. Oak
S9°W 19.50' to set N & T in W. side 8" R. Maple
N15°W 30.57' to set N & T in E. side 10" R. Maple
N72°W 71.04' to set N & T in N. side 5" R. Pine

6 - 3/4" iron pipe
Set Blue Carsonite Post with loc. tag 1' NE
N80°W 46.28' to set N & T in N. side 11" R. Maple
N22°E 16.49' to set N & T in W. side 6" R. Maple
N88°E 40.87' to set N & T in N. side 13" R. Maple
S23°E 33.05' to set N & T in W. side 5" R. Maple Clp. - 4

Signed by: Craig W. McVean
Surveyor's Michigan License No.: 39088

Date: 4/21/2009

