

LAND CORNER RECORDATION CERTIFICATE

FILING REQUIREMENT OF ACT 74, MICH. P.A.1970

FOR CORNERS OF--:	LOCATED IN--:	CORNER CODE NUMBER
1. PUBLIC LAND SURVEY	T. <u>20</u> N. <u>13</u> E. <u>13</u> W.	<u>K-7, L-7, M-7</u>
2. PROPERTY CONTROLLING IN SECTION	<u>13</u> , T. <u>20</u> N. <u>13</u> E. <u>13</u> W.	<u>15</u>
3. MISCELLANEOUS PROPERTY IN SECTION	T. _____ N. _____ E. _____ S. _____ R. _____ W. _____	
4. LOT NO. _____, RECORDED PLAT _____		
5. PRIVATE CLAIMS _____		

REGISTER OF DEEDS STAMP AND FILING NUMBER

I, Carl F. Roser do hereby certify that under requirements of P.A. 74, Michigan P.A. of 1970, the corner points mentioned in lines 1 and 2 above (identified with circles on index code diagram—over) were, in a field survey on 9-7-73 19___, established, re-established, monumented, re-monumented, recovered or restored as expressed below and in conformance with regulations and rules therefore as required in the current manual of survey instructions of the United States Department of the Interior, Bureau of Land Management or by a decree of a court of law. Furthermore, that the corner points mentioned in lines 3, 4 and 5 above were, in a field survey on _____ 19___, found, recovered, restored, established or re-established as expressed below and in conformance with the rules of the Michigan State Board of Registration for Land Surveyors or, by a Decree of a Court of law:

A. Description of original monument or monuments	B. Cont. Cor. Code #15	C. Cont. Cor. Code #15
Fd. "T" Ir. with Brass Tag on top.	Fd. "T" Ir. with Brass Tag on top.	Fd. Brass "T" Ir. - Added Cor. Post w/loc. Tag.
		<u>2" Map. N25°W 15.77'</u>
		<u>NW Cor. Conc. Blk. N50°E 88.7'</u>
		<u>Cabin Fdn.</u>
		<u>P. Pole w/transf. S45°E 65.70'</u>
		<u>Ctr. E-W Sand Rd. Due S. 21'</u>

B. Description of corner evidence found and/or method applied in restoring or re-establishing corner:

<u>K-7</u>	<u>L-7</u>	<u>M-7</u>
<u>Fd. yellow top "T" Ir. with Consumers Power Co. property tag on top & 1x4" white top 3/4k.</u>	<u>Fd. Geo. Brass Cor. Conc. Mon. w/brass Cap. as recorded in L. 2 - P. 15.</u>	<u>Fd. 1 1/2 x 18" Pipe as previously used by G. Bloss.</u>

C. Description of monument for corner and accessories established to perpetuate locating the position of the corner:

<u>K-7</u>	<u>L-7</u>	<u>M-7</u>
<u>Fd. C.P.C. "T" Ir. Added Cor. Guard Post w/loc. Tag.</u>	<u>Blk. Wit. as Rec. in L. 2 - P. 15</u>	<u>Fd. 1 1/2" Pipe - Added DNR. Mon. buried 7" in Sand Rd. intersection.</u>
<u>13" R. Pine N42°W 48.7'</u>	<u>8" B. Oak S60°W 37.27'</u>	<u>N" B. Oak N57°E 116.4'</u>
<u>4" W. Oak S80°E 4.8'</u>	<u>23" B. Oak Stp. N10°E 54.43'</u>	<u>7" B. Oak S55°E 113.1'</u>
<u>1" B. Oak S35°W 14.3'</u>	<u>P. Pole S70°E 94.33'</u>	<u>22" B. Oak N73°W 131.4'</u>
	<u>Conc. Mon. (buried) in S. edge of E-W dirt Rd.</u>	<u>Set Cor. Post w/loc. Tag N45°E 66'</u>
	<u>DNR Set Cor. Post w/loc. Tag Due N. 33'</u>	

SIGNED BY Carl F. Roser DATE 9-17-73

SURVEYOR'S MICHIGAN REGISTRATION NO. 12028


FOR STATE AND UNITED STATES AGENCIES:

SIGNED BY _____ DATE _____

CHIEF OF SURVEY PARTY

APPROVED AND SIGNED BY _____ DATE _____

MICHIGAN REGISTERED LAND SURVEYOR

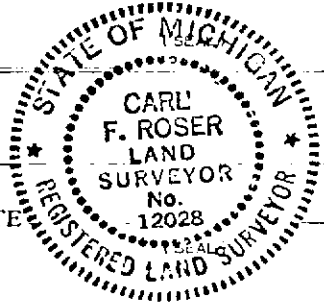

SURVEYOR'S MICHIGAN REGISTRATION NO. _____