LAND CORNER RECORDATION CERTIFICATE

Filing Requirement of Act 74, Mich. P.A. 1970

For corners in
LAKE
(County)

	Located In:	Corner Code ##
1. Public Land Survey	T 20N R 13W	I-5, J-5
	T R	
	T R	
	T R	
2. Property Controlling	S 14 T R	1, 5
in Section	S T R	
3. Miscellaneous	S T R	
Property in Sec.	S T R	

Register of Deeds Stamp & File Number

4. Lot No. _____, Recorded Plat _____
5. Private Claims _____

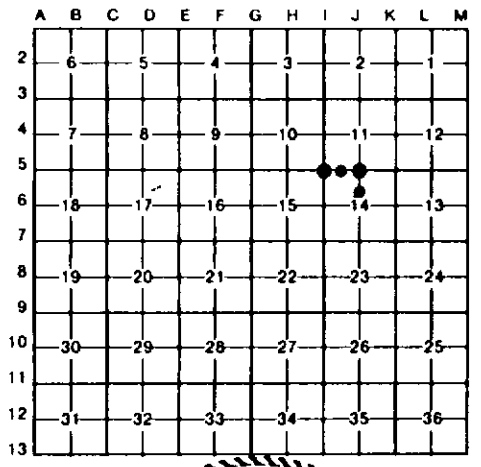

I, CARL T. KIISKILA, in a field survey on JUNE 29, 19 94, do hereby certify that under requirements of P.A. 74, Michigan P.A. of 1970, the corner points mentioned in lines 1 and 2 above were in conformance with regulations and rules therefore as required in the current manual of survey instructions of the United States Department of the Interior, Bureau of Land Management or by a decree of a Court of Law and/or that the corner points mentioned in lines 3, 4 and 5 above were in conformance with the rules of the Michigan Board of Land Surveyors or by a Decree of a Court of Law; established, re-established, monumented, re-monumented, recovered, found as expressed below:

NOTE: Not more than 4 corners, all in the same town and range, may be recorded on this certificate.

STATE OF MICHIGAN
CARL KIISKILA
LAND SURVEYOR
No. 33981
LICENSED LAND SURVEYOR

A. Description of original monument and accessories and/or subsequent restoration:

I-5 J-5 1

(NO EVIDENCE OF G.L.O. CORNER, B.T'S, LINE TREES & TOPOGRAPHY, AS CALLED OUT IN THE G.L.O. LINE NOTES; UNLESS NOTED IN ITEM "B" BELOW.)

B. Description of corner evidence found and/or method applied in restoring or reestablishing corner:

I-5
FD CONC MON FOR NW COR S-14. COR FITS 1989 CERT OF SURVEY BY C.COLE (LI 3, PG 210). COR IS BURIED 7" IN APPROX CTR OF N-S GRAVEL ROAD. CTR OF SAND RD E IS 3' NORTH.

J-5
FD CONC MON FOR N 1/4 COR S-14. MON IS BURIED 7" IN OLD E-W ROAD GRADE. MON FITS TWO FD DEAD J.PINE WITS PER 1984 CERT OF SURVEY BY R.WETHERELL (LI 2, PG 502). OLD E-W RD GRADE IS SOUTH BANK OF LARGE BEAVER FLOODING, (TREES ALL DEAD IN FLOODING AND TREES SOUTH OF RD BED ALSO DEAD.)

1
ESTAB'D THE NE COR OF NW 1/4 OF NW 1/4 OF S-14 PER STANDARD BLM PROCEDURE. CORNER FITS 1989 CERT OF SURVEY BY C.COLE (LI.3, PG.210) IN SW 1/4 S-11. CTR OF E-W SAND RD IS 3' N.

5
FD 1/2" REROD FOR THE SE COR OF NE 1/4 NW 1/4 S-14 PER CERT OF SURVEY BY R. WETHERELL, LIBER 2, PG 502 DATED MARCH 14, 1983.

C. Description of monument for corner and accessories established to perpetuate locating the position of the corner:

I-5
FD USFS CONC BRASS CAP MON.

#15" B OAK	N70°W	72.66'
#SW COR CONC HOUSE FND.	N40°E	115.2'
9" J PINE	S50°E	64.23'
#11" B OAK	S45°W	64.38'

#PS R.A.GRIFFIN 1967 WIT.

J-5
FD BRASS CAP CONC MON WITH 3/4" IR ROD FOR GUARD. NO AVAIL TREES FOR WIT.

DR 5/8" X 32" REROD W/PS CAP S89°40'13"E 1342.30'
DR 5/8" X 32" REROD W/PS CAP N88°41'16"W 1334.87'
CTR OLD ABANDONED E-W RD GRADE SOUTH 4'

1
DR 5/8" X 34" REROD W/RLS CAP.

7" CLP B OAK	N40°W	35.4'
7" W OAK	S35°E	40.7'
8" J PINE	S55°W	28.0'
FD 1/2" IR W/ RLS CAP.	NORTH	32.95'
SET CED POST W/ LOC TAG.	SOUTH	33'

5
FD 1/2" REROD W/RLS CAP. ADDED CED POST W/LOC TAG.

4" J PINE	N45°W	11.2'
19" TW B OAK	N40°E	8.2'
5" J PINE	S05°W	8.8'
FD 1/2" REROD W/PS CAP	EAST	168.44'

Signed by Carl T Kiiskila Date 5-16-97

Surveyor's Michigan License No. 33981

FORM APPROVED BY MICHIGAN STATE BOARD OF LAND SURVEYORS, JAN. 28, 1971
REVISED MAY 14, 1975
REVISED JAN., 1983