

LAND CORNER RECORDATION CERTIFICATE
Filing Requirement of Act 74, Mich. P.A. 1970

For corners in
LAKE

(County)	Located In:	Corner Code #
1. Public Land Survey	T 20N R 13W	M-12, M-11
	T _____ R _____	_____
	T _____ R _____	_____
	T _____ R _____	_____
2. Property Controlling in Section	S 36 T _____ R _____	13, 14
	S _____ T _____ R _____	_____
3. Miscellaneous Property in Sec.	S _____ T _____ R _____	_____
	S _____ T _____ R _____	_____

Register of Deeds Stamp & File Number

4. Lot No. _____, Recorded Plat _____
 5. Private Claims _____


I, CARL T. KIISKILA, in a field survey on AUGUST 10, 1995, do hereby certify that under requirements of P.A. 74, Michigan P.A. of 1970, the corner points mentioned in lines 1 and 2 above were in conformance with regulations and rules therefore as required in the current manual of survey instructions of the United States Department of the Interior, Bureau of Land Management or by a decree of a Court of Law and/or that the corner points mentioned in lines 3, 4 and 5 above were in conformance with the rules of the Michigan Board of Land Surveyors or by a Decree of a Court of Law; established, re-established, monumented, re-monumented, recovered, found as expressed below:

NOTE: Not more than 4 corners, all in the same town and range, may be recorded on this certificate.

A. Description of original monument and accessories and/or subsequent restoration:

{NO EVIDENCE OF G.L.O. CORNER, B.T.'S, LINE TREES & TOPOGRAPHY, AS CALLED OUT IN THE G.L.O. LINE NOTES; UNLESS NOTED IN ITEM "B" BELOW.}

	A	B	C	D	E	F	G	H	I	J	K	L	M
2	6	5	4	3	2	1							
3													
4	7	8	9	10	11	12							
5													
6	18	17	16	15	14	13							
7													
8	19	20	21	22	23	24							
9													
10	30	29	28	27	26	25							
11													
12	31	32	33	34	35	36							
13													

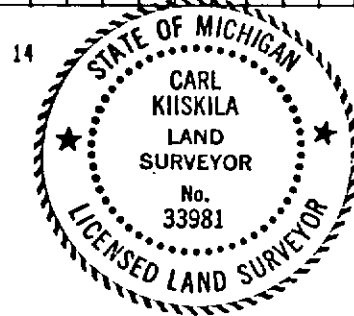

B. Description of corner evidence found and/or method applied in restoring or reestablishing corner:

M-12	M-11	13	14
REESTAB'D THE E 1/4 COR S-36 MIDWAY & ON LINE BETWEEN FD SEC CORS 1/2 MILE TO N & S. COR FITS 1956 SURVEY DATA BY G.BLASS IN S-36 & C.COLE CERT OF SURVEY LI 2, PG 134. COR FALLS ON STEEP S'LY SLOPE, 100'+/- N OF BOTTOM OF SLOPE.	FD "T" IRON FOR SE COR SEC 25. COR FD & WITNESSED BY G.BLASS IN 1948 & 1956. 1988 DNR COR OF RECORD T20N-R12W, A-11. COR IS BURIED 8" IN CTR E-W TRAIL & IN LINE W/CENTER TRAIL TO NORTH.	ACCEPTED 1/2" PIPE FOR CTR OF SE 1/4 OF SEC 36. COR ESTABLISHED BY C.COLE IN 1976 CERT OF SURVEY (LI 2, PG 134) & REVISED 7/14/77 (LI 2, PG 238).	SET 5/8" REROD FOR SE COR OF NE 1/4 OF SE 1/4 SEC 36 PER STANDARD BLM PROCEDURE. THIS POSITION FITS 1956 G.BLASS SEC 36 SUB'D DATA & 1977 C.COLE CERT OF SURVEY LI 2, PG 238. CTR OF WINDING TRAIL (NW-SE) IS 28' NORTH.

C. Description of monument for corner and accessories established to perpetuate locating the position of the corner:

M-12	M-11	13	14
SET DNR MON & CARSONITE POST.	FD 1 1/2" "T" IRON.	FD 1/2" PIPE. ADDED CARSONITE POST W/LOC TAG.	DROVE 5/8" X 3/4" REROD W/RLS CAP. SET CARSONITE POST.
10" W PINE N50°W 35.1'	14" W OAK N15°W 29.75'		
3" W PINE N88°E 13.4'	3" MAPL (CLP5) N50°E 68.31'	13" B OAK N35°W 3.6'	3" MAPL (CLP4) N50°W 19.6'
3" W PINE S45°E 3.9'	15" TW B OAK S35°E 51.67'	5" W PINE N20°W 27.0'	3" MAPL (CLP5) N75°E 7.0'
15" TW B CHERRY S30°E 14.1'	14" B OAK S20°W 32.22'	3" W PINE N50°E 4.2'	7" R OAK S10°W 8.7'
	CED POST W/ DNR LOC TAG. SOUTH 33'	5" W PINE S75°E 22.3'	8" MAPLE S70°W 12.3'
			FD 1/2" PIPE S10°13'W 2.12'

1=RLS G. BLASS 1948 WIT & 1988 DNR WIT.

Signed by Carl T. Kiiskila Date 5-16-97

Surveyor's Michigan License No. 33981