LAND CORNER RECORDATION CERTIFICATE

Filing Requirement of Act 74, Mich. P.A. 1970

For corners in LAKE (County)

	Located In:	Corner Code ##
1. Public Land Survey	T 20N R 13W	I-13, J-13
	T ___ R ___	
	T ___ R ___	
	T ___ R ___	
2. Property Controlling	S 35 T ___ R ___	10, 11
in Section	S ___ T ___ R ___	
3. Miscellaneous	S ___ T ___ R ___	
Property in Sec.	S ___ T ___ R ___	

Register of Deeds Stamp & File Number

4. Lot No. _____ , Recorded Plat _____
5. Private Claims _____

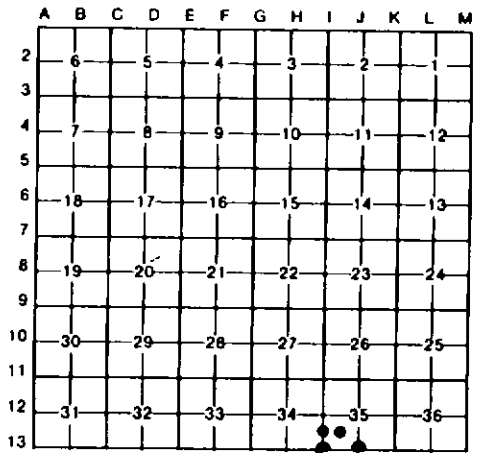

I, CARL T. KIISKILA, in a field survey on JUNE 12, 19 95, do hereby certify that under requirements of P.A. 74, Michigan P.A. of 1970, the corner points mentioned in lines 1 and 2 above were in conformance with regulations and rules therefore as required in the current manual of survey instructions of the United States Department of the Interior, Bureau of Land Management or by a decree of a Court of Law and/or that the corner points mentioned in lines 3, 4 and 5 above were in conformance with the rules of the Michigan Board of Land Surveyors or by a Decree of a Court of Law; established, re-established, monumented, re-monumented, recovered, found as expressed below:

NOTE: Not more than 4 corners, all in the same town and range, may be recorded on this certificate.

A. Description of original monument and accessories and/or subsequent restoration:

I-13 J-13 10 11

(NO EVIDENCE OF G.L.O. CORNER, B.T'S, LINE TREES & TOPOGRAPHY, AS CALLED OUT IN THE G.L.O. LINE NOTES; UNLESS NOTED IN ITEM "B" BELOW.)

STATE OF MICHIGAN
CARL KIISKILA
LAND SURVEYOR
No. 33981
LICENSED LAND SURVEYOR

B. Description of corner evidence found and/or method applied in restoring or reestablishing corner:

I-13
FD CONC MON FOR SW COR SEC 35. G. BLASS RECORDED AN ANGLE IR AT THIS LOCATION IN 1941. R. GRIFFEN SET USFS MON IN ITS PLACE IN 1963 AND TOOK NEW WITS. COR IS IN LINE W/SAND RD TO WEST & 2-TRACK EAST. CTR OF N-S GRAVEL RD IS 2' EAST.

J-13
FD 1/2" PIPE FOR S 1/4 S-35. COR FITS WORK DONE IN NW 1/4 OF SW 1/4 S-35 BY R. WETHERELL (1990, LI 3, PG 242). CTR OF E-W SAND TRAIL IS 10' SOUTH.

10
FD 3/4" PIPE FOR NW COR OF SW 1/4 OF SW 1/4 OF SEC 35. PIPE FITS 1990 CERT OF SURVEY BY R.WETHERELL (LI 3, PG 242). CTR OF N-S SAND ROAD IS 4' WEST.

11
ESTABLISHED THE CTR OF SW 1/4 S-35 PER STANDARD BLM PROCEDURE. THIS POSITION FITS 1990 CERT OF SURVEY BY R.WETHERELL (LI 3, PG 242) IN NW 1/4 OF SW 1/4 S-35.

C. Description of monument for corner and accessories established to perpetuate locating the position of the corner:

I-13
FD USFS CONC BRASS CAP MON.

#31" B OAK	N55°W	103.60'
#10" R PINE	N35°W	88.15'
##20" B OAK	N60°E	38.90'
FD USFS MON NW - SEC 2, T19N-R13W	S89°08'E	12.59'

#=RLS G. BLASS 1941 WIT.
#=PS R.A.GRIFFIN 1963 WIT.

J-13
REPLACED FD 1/2" X 16" GALV PIPE W/DNR MON. SET CED POST.

5" W PINE	N40°W	56.5'
6" W PINE	N40°E	51.4'
7" R PINE	S15°E	28.2'
5" R PINE	S10°W	26.3'
DNR MON N1/4 SEC 2, T19N-13W	S89°07'E	10.93'

10
FD 3/4" GALV PINCH PIPE.

19" R PINE	S70°E	22.7'
7" CLP MAPLE	S40°E	29.3'
8" CLP MAPLE	S60°W	39.0'
SET CED POST W/LOC TAG AT FD 1/2" REROD W/ RLS CAP #17615	EAST	33'

11
SET 5/8" X 34" REROD W/PS CAP. DROVE CARSONITE POST.

6" W PINE	N30 W	22.7'
9" W PINE	EAST	18.8'
5" W PINE	S30 E	7.2'
3" W PINE	WEST	8.3'
FD OLD 1/2" X 2 1/4" IRON	S85 33'W	6.33'

Signed by Carl T Kiiskila Date 5-16-97

Surveyor's Michigan License No. 33981

FORM APPROVED BY MICHIGAN STATE BOARD OF LAND SURVEYORS, JAN. 28, 1971
REVISED MAY 14, 1975
REVISED JAN., 1983