LAND CORNER RECORDATION CERTIFICATE

Filing Requirement of Act 74, Mich. P.A. 1970

For corners in
LAKE
(County)

	Located In:	Corner Code ##
1. Public Land Survey	T 20N R 13W	K-6, M-5,
	T R	M-6
	T R	
	T R	
2. Property Controlling	S 13 T R	10
in Section	S T R	
3. Miscellaneous	S T R	
Property in Sec.	S T R	

Register of Deeds Stamp & File Number

4. Lot No. _____ , Recorded Plat _____
5. Private Claims _____

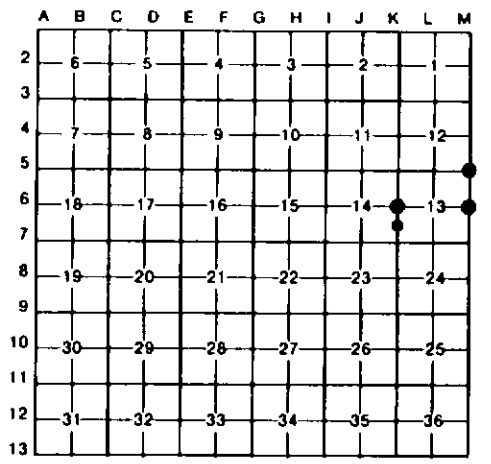

I, CARL T. KIISKILA , in a field survey on JUNE 30 , 19 94 , do hereby certify that under requirements of P.A. 74, Michigan P.A. of 1970, the corner points mentioned in lines 1 and 2 above were in conformance with regulations and rules therefore as required in the current manual of survey instructions of the United States Department of the Interior, Bureau of Land Management or by a decree of a Court of Law and/or that the corner points mentioned in lines 3, 4 and 5 above were in conformance with the rules of the Michigan Board of Land Surveyors or by a Decree of a Court of Law; established, re-established, monumented, re-monumented, recovered, found as expressed below:

NOTE: Not more than 4 corners, all in the same town and range, may be recorded on this certificate.

A. Description of original monument and accessories and/or subsequent restoration:

K-6 M-5 M-6 10

(NO EVIDENCE OF G.L.O. CORNER, B.T'S, LINE TREES & TOPOGRAPHY, AS CALLED OUT IN THE G.L.O. LINE NOTES; UNLESS NOTED IN ITEM "B" BELOW.)

STATE OF MICHIGAN
CARL KIISKILA
LAND SURVEYOR
No. 33981
LICENSED LAND SURVEYOR

B. Description of corner evidence found and/or method applied in restoring or reestablishing corner:

K-6
FD "T" IRON FOR W 1/4 COR S-13. COR FITS ONE WIT PER C.COLE CERT OF SURVEY DATED 5/29/90, FILE 5424-90. METAL TAG ON IRON IS FROM BLASS SURVEYS. CENTER N-S SAND ROAD IS 2' W.

M-5
FD PIPE FOR NE COR S-13. G. BLASS RECORDS SHOW: "FD 1" PIPE" IN 1964. WE REASONABLY FIT ONE OF HIS WITS: "8" J.PINE S27 E 69.96". COR IS IN INTERSEC OF SAND RDS E-W-S & 12' EAST OF SAND ROAD TO N.

M-6
REESTABLISHED THE E 1/4 COR OF SEC 13 MIDWAY & ON LINE BETW FD SEC CORS 1/2 MILE N & S. COR FALLS IN CTR N-S SAND RD. CTR OF E-W MOTOR SPORT TRAIL IS 103' NORTH.

10
ESTAB'D THE SW COR OF THE NW 1/4-SW 1/4 S-13 PER STANDARD BLM PROCEDURE. COR FITS LAKE STATE SUR & ENG SEC 13 SUBDIVISION. COR FALLS IN CTR N-S SAND ROAD. CTR OF SAND TRAIL SE'LY IS 92'+/- 10' SOUTH.

C. Description of monument for corner and accessories established to perpetuate locating the position of the corner:

K-6
FD 3/4" X 3/4" T IRON W/METAL TAG.

8" B OAK	N60°W	29.31'
2" W OAK	N60°E	16.30'
*9" B OAK	S40°W	38.35'
SET CED POST W/ LOG TAG.	EAST	33'

*WIT BY C. COLE.

M-5
FD OLD 3/4" PIPE.

*FD PK IN POWER POLE	N45°W	46.27'
*FD PK IN GUY POLE	N25°E	35.05'
*13" J PINE	S25°E	70.30'
*FD PK IN GUY POLE	S30°W	71.15'

*WIT BY OTHERS.

M-6
DR 5/8" X 34" REROD W/PS CAP.

8" J PINE	N40°W	45.61'
9" J PINE	N50°E	27.47'
9" J PINE	S55°E	24.29'
SET CED POST W/ LOG TAG.	EAST	33'

10
DR 5/8" X 34" REROD W/RLS CAP.

5" W PINE	N55°W	69.4'
8" W OAK	N55°E	26.3'
POWER POLE	S25°E	130.30'
2" W PINE	S45°W	53.1'
SET CED POST W/ LOC TAG.	EAST	33'

Signed by Carl T. Kiiskila Date 5-16-97

Surveyor's Michigan License No. 33981

FORM APPROVED BY MICHIGAN STATE BOARD OF LAND SURVEYORS, JAN. 28, 1971
REVISED MAY 14, 1975
REVISED JAN., 1983