# LAND CORNER RECORDATION CERTIFICATE

**Filing Requirement of Act 74, Mich. P.A. 1970**

For corners in LAKE (County)

| | Located In: | Corner Code ## |
|---|---|---|
| 1. Public Land Survey | T 20N R 13W | I-6, I-7, |
| | T R | I-8, J-7 |
| | T R | |
| | T R | |
| 2. Property Controlling | S T R | |
| in Section | S T R | |
| 3. Miscellaneous | S T R | |
| Property in Sec. | S T R | |

**Register of Deeds Stamp & File Number**

4. Lot No. , Recorded Plat
5. Private Claims

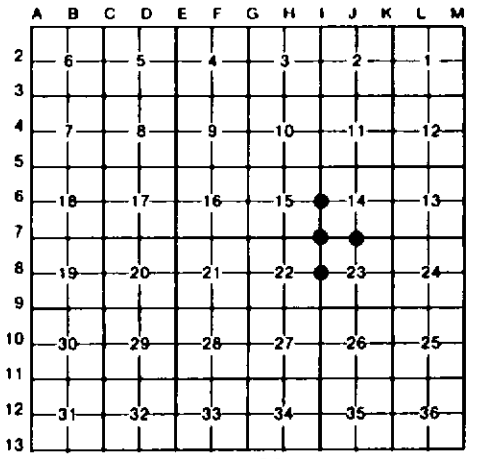


I, CARL T. KIISKILA, in a field survey on JULY 7, 19 94, do hereby certify that under requirements of P.A. 74, Michigan P.A. of 1970, the corner points mentioned in lines 1 and 2 above were in conformance with regulations and rules therefore as required in the current manual of survey instructions of the United States Department of the Interior, Bureau of Land Management or by a decree of a Court of Law and/or that the corner points mentioned in lines 3, 4 and 5 above were in conformance with the rules of the Michigan Board of Land Surveyors or by a Decree of a Court of Law; established, re-established, monumented, re-monumented, recovered, found as expressed below:

**NOTE: Not more than 4 corners, all in the same town and range, may be recorded on this certificate.**

J-7

STATE OF MICHIGAN
CARL KIISKILA
LAND SURVEYOR
No. 33981
LICENSED LAND SURVEYOR

A. Description of original monument and accessories and/or subsequent restoration:

I-6 I-7 I-8

(NO EVIDENCE OF G.L.O. CORNER, B.T'S, LINE TREES & TOPOGRAPHY, AS CALLED OUT IN THE G.L.O. LINE NOTES; UNLESS NOTED IN ITEM "B" BELOW.)

B. Description of corner evidence found and/or method applied in restoring or reestablishing corner:

| I-6 | I-7 | I-8 | J-7 |
|---|---|---|---|
| FD CONC MON FOR W 1/4 COR S-14. COR FITS S-14 SURVEY INFO BY R.WETHERELL. CTR OF 23' WIDE N-S SAND RD IS 2' WEST. | FD CONC MON FOR SW COR S-14. COR FITS R.WETHERELL SURVEY DATA IN S-14 & 1989 CERT OF SURVEY BY S.BARNETT (LI 3, PG 191) IN S-22. CTR OF 24'+/- WIDE N-S SAND/GRAVEL RD IS 12' WEST. | FD CONC MON FOR W 1/4 COR SEC 23. COR FITS CERT OF SURVEYS: 1983 R.WETHERELL LI 2, PG 438; 1987 CLINT COLE LI 3, PG 117; 1989 S.BARNETT LI 3, PG 191 CTR OF SAND RD W'LY IS 17'+/- SOUTH. | REESTAB'D THE S 1/4 SEC 14 MIDWAY & ON LINE BETWEEN FD SECTION CORNERS 1/2 MILE EAST & WEST. COR FITS SURVEY WORK IN SEC 14 BY R.WETHERELL AND IN SEC 23 BY C.COLE. |

C. Description of monument for corner and accessories established to perpetuate locating the position of the corner:

| I-6 | | | I-7 | | | I-8 | | | J-7 | | |
|---|---|---|---|---|---|---|---|---|---|---|---|
| FD BRASS CAP CONC MON. | | | FD BRASS CAP CONC MON. | | | FD BRASS CAP CONC MON IN CTR N-S SAND RD. | | | SET DNR MON AND CED POST. | | |
| ‡ 9" B OAK | N55°W | 66.98' | ‡ 7" R OAK | S60°W | 58.27' | POWER POLE | N85°W | 32.89' | 4" MAPLE | N50°W | 18.0' |
| ‡12: W OAK | N70°E | 62.78' | ‡ 9" W OAK | N60°W | 79.83' | ‡12" B OAK | N48°E | 87.67' | 5" R OAK | N20°E | 18.2' |
| ‡10" B OAK | S70°E | 64.18' | ‡18" W PINE | N63°E | 133.85' | ‡11" W OAK | S80°E | 50.23' | 5" R OAK | S60°E | 7.4' |
| ‡10" B OAK | S80°W | 69.03' | 3" R OAK | S55°E | 50.25' | ‡10" MAPLE | S55°W | 84.26' | 6" R OAK | S20°W | 4.0' |
| FD 4" X 4" POST | WEST | 33' | SET CED POST W/ LOC TAG | EAST | 33' | SET CED POST W/LOC TAG AT FD IR W/RLS CAP | EAST | 33' | FD 11" X 8" X 7" ABOVE GRD PINK STONE | DUE E | 63.5' |
| ‡R.GRIFFIN (USFS) 1967 WIT. | | | ‡R.GRIFFIN 1967 WIT. | | | ‡1967 USFS WIT (R.GRIFFIN) | | | | | |

Signed by Carl T Kiiskila Date 5-16-97

Surveyor's Michigan License No. 33981

FORM APPROVED BY MICHIGAN STATE BOARD OF LAND SURVEYORS, JAN. 28, 1971
REVISED MAY 14, 1975
REVISED JAN., 1983