LAND CORNER RECORDATION CERTIFICATE

Filing Requirement of Act 74, Mich. P.A. 1970

For corners in

LAKE (County)

		Located In:	Corner Code ##
1. Public Land Survey		T 20N R 13W	K-7, L-7
		T ___ R ___	M-7
		T ___ R ___	
		T ___ R ___	
2. Property Controlling	S 13	T ___ R ___	15
in Section	S	T ___ R ___	
3. Miscellaneous	S	T R	
Property in Sec.	S	T R	

Register of Deeds Stamp & File Number

4. Lot No. _____ , Recorded Plat _____

5. Private Claims _____

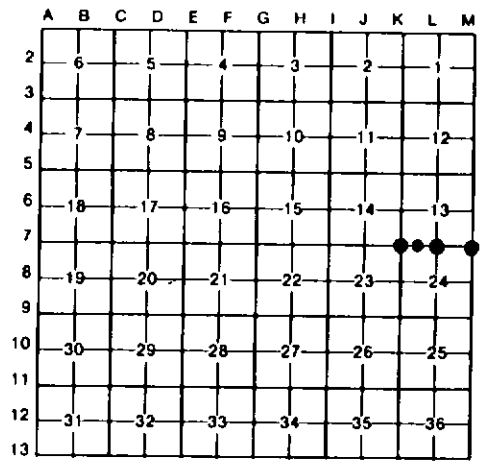

I, CARL T. KIISKILA, in a field survey on AUGUST 9, 19 95, do hereby certify that under requirements of P.A. 74, Michigan P.A. of 1970, the corner points mentioned in lines 1 and 2 above were in conformance with regulations and rules therefore as required in the current manual of survey instructions of the United States Department of the Interior, Bureau of Land Management or by a decree of a Court of Law and/or that the corner points mentioned in lines 3, 4 and 5 above were in conformance with the rules of the Michigan Board of Land Surveyors or by a Decree of a Court of Law; established, re-established, monumented, re-monumented, recovered, found as expressed below:

NOTE: Not more than 4 corners, all in the same town and range, may be recorded on this certificate.

A. Description of original monument and accessories and/or subsequent restoration:

K-7 L-7 M-7 15

(NO EVIDENCE OF G.L.O. CORNER, B.T'S, LINE TREES & TOPOGRAPHY, AS CALLED OUT IN THE G.L.O. LINE NOTES; UNLESS NOTED IN ITEM "B" BELOW.)

STATE OF MICHIGAN
CARL KIISKILA
LAND SURVEYOR
No. 33981
LICENSED LAND SURVEYOR

B. Description of corner evidence found and/or method applied in restoring or reestablishing corner:

K-7
FD "T" IRON FOR SW S-13 1973 DNR COR OF RECORD. CORNER FITS 1981 R. WETHERELL CERT OF SURVEY & 1990 C. COLE CERT OF SURVEY. COR IS IN LINE W/CTR SAND RD N & E.

L-7
FD CONC MON FOR S 1/4 COR S-13, 1973 DNR CORNER OF RECORD. COR FITS CERT OF SURVEYS, 1971 BY G. BLASS (LI 107, PG 31 & LI 1, PG 115) & 1981 BY R.WETHERELL. CTR OF E-W SAND/GRVL RD IS 2' NORTH. CTR WINDING SAND TRAIL S'LY IS 13'+/- EAST.

M-7
FOUND DNR MON AS SET IN 1973 DEPT SURVEY AT POSITION OF FOUND 1 1/2" PIPE FOR SE COR S-13. G. BLASS FD PIPE IN 1966. COR IS IN APPROX DIRT ROAD INTERSEC N-S-E-W.

15
FD CONC MON FOR SW COR OF SE 1/4 OF SW 1/4 S-13. IN 1973 DEPT SURVEY WE FOUND "T" IRON W/RLS TAG AT THIS POSITION. PROPERTY OWNER SAID HE POURED CONC AROUND IRON. CENTER E-W SAND/GRAVEL RD IS 21'+/- SOUTH.

C. Description of monument for corner and accessories established to perpetuate locating the position of the corner:

K-7
FD 3/4" 'T' IRON W/CONS POWER CO METAL TAG & CED POST W/LOC TAG.

# 8" W OAK	N85°W	28.73'
# 14" R PINE	N42°W	48.7'
# 7" MAPLE	N20°W	20.25'
##17" W OAK	S80°E	5.53'
# 13" R OAK	S35°W	14.3'

#=1973 DNR WIT.
#=PS C. COLE 1990 WIT.

L-7
FD BRASS CAP CONC MON.

7" J PINE	N50°W	43.15'
#11" B OAK	N20°E	26.02'
#POWER POLE	S65°E	94.33'
POWER POLE	S25°E	44.14'
CED POST W/DNR LOC TAG	NORTH	33'

#=WIT BY OTHERS.
#=RLS G. BLASS & DNR WIT.

M-7
FD DNR MON.

#28" B OAK	N73°W	132.10'
#9" CLP4 B OAK	S55°E	113.32'
8" W PINE	S35°W	55.45'
POWER POLE	S75°W	86.46'
CED POST W/DNR LOC TAG.	N45°E	66'

#1973 DNR WIT.

15
FD CONC MON W/METAL SUR TAG.

#8" MAPLE (FACE)	N25°W	16.1'
#NW COR CONC BLK CABIN FDN	N50°E	88.7'
#P POLE W/TRANSF	S45°E	65.7'
FD IR IN CONC W/ RLS CAP.	N89°34'E	35.83

FD IR IN CONC W/RLS CAP; ADDED CED POST N89°34'E 131.95
#=1973 DNR WIT.

Signed by Carl T Kiiskila Date 5-16-97

Surveyor's Michigan License No. 33981

FORM APPROVED BY MICHIGAN STATE BOARD OF LAND SURVEYORS, JAN. 28, 1971
REVISED MAY 14, 1975
REVISED JAN., 1983