

SURVEY & REMONUMENTATION

JAN 14 1998

LAND CORNER RECORDATION CERTIFICATE
Filing Requirement of Act 74, Mich. P.A. 1970

For corners in Lake

SECTION

(County)	Located In:	Corner Code #
1. Public Land Survey	T <u>20N</u> R <u>13W</u>	<u>A-3</u> ✓
	T <u>20N</u> R <u>14W</u>	<u>M-3</u>
	T _____ R _____	_____
	T _____ R _____	_____
2. Property Controlling in Section #	S _____ T _____ R _____	_____
	S _____ T _____ R _____	_____
3. Miscellaneous Property in Sec.	S _____ T _____ R _____	_____
	S _____ T _____ R _____	_____

RECORDED
 LAKE COUNTY, MI.
 LIBER 004 PAGE 0095
 DEC 12 11 38 AM '97

Shirley H. Dechant
 REGISTER OF DEEDS

Register of Deeds Stamp & File Number

4. Lot No. _____, Recorded Plat _____
 5. Private Claims _____

	A	B	C	D	E	F	G	H	I	J	K	L	M
2	6	5	4	3	2	1							
3	7	8	9	10	11	12							
4	18	17	16	15	14	13							
5	19	20	21	22	23	24							
6	30	29	28	27	26	25							
7	31	32	33	34	35	36							
8													
9													
10													
11													
12													
13													

I, Robert L. Wetherell, in a field survey on August 29, 19 97, do hereby certify that under requirements of P.A. 74, Michigan P.A. of 1970, the corner points mentioned in lines 1 and 2 above were in conformance with regulations and rules therefore as required in the current manual of survey instructions of the United States Department of the Interior, Bureau of Land Management or by a decree of a Court of Law and/or that the corner points mentioned in lines 3, 4 and 5 above were in conformance with the rules of the Michigan Board of Land Surveyors or by a Decree of a Court of Law; established, re-established, monumented, re-monumented, recovered, found as expressed below:

NOTE: Not more than 4 corners, all in the same town and range, may be recorded on this certificate.

A. Description of original monument and accessories and/or subsequent restoration:

- | | | | |
|---|---------------------------------------|-------------------------------|---|
| <u>A-3; M-3 - Section corner common to Section 6, T20N, R13W and Section 1, T20N, R14W, Lake Co., Mi.</u> | <u>1837 - John Mullett, G.L.O.</u> | <u>1905 - J.W. Nicholson</u> | <u>Undated - George Johnson, Co. Sur.</u> |
| <u>#1 - 8" Maple N60°W 4 Links</u> | <u>#3 - 8" Elm S19-1/4°W 63 Links</u> | <u>3 Foot Gas Pipe</u> | <u>#6 - 10" Y. Pine Stump N6°W 30'</u> |
| <u>#2 - 10" Birch S29°W 47 Links</u> | <u>#4 - 30" W. Pine Stump</u> | <u>N28-1/2°W 33-1/2 Links</u> | <u>#7 - 8" B. Oak N73°W 19-1/2'</u> |
| | <u>#5 - 30" W. Pine Stump</u> | <u>S59°E 54-1/2 Links</u> | |

(SEE OVER FOR CONTINUATION OF "A")

B. Description of corner evidence found and/or method applied in restoring or reestablishing corner.

A-5; M-5; Section corner common to Section 5, T20N, R13W and Section 12, T20N, R14W, Lake Co., Mi.

I found the 5" Square Concrete Monument by Griffin in the center of a North and South black top road.
 Condition of the accessories are as follows: #1 Gone, #2 Gone, #3 gone, #4 Gone, #5 Found rotted stump, #6 gone, #7 Gone, #8 Found Stump, #9 Found Stub, #10 Found in good condition, #11 Found in good condition, #12 Found stump.

RATIFIED BY THE LAKE CO. PEER REVIEW GROUP
 IN ACCORDANCE WITH P.A. 345
 CHAIRMAN R. & W.
 DATE 12-10-97


C. Description of monument for corner and accessories established to perpetuate locating the position of the corner:

A-5; M-5; Section corner common to Section 5, T20N, R13W and Section 12, T20N, R14W, Lake Co., Mi.

I accepted the 5" Square Concrete Monument as a substantial marker for the corner, and is accepted as a careful and faithful re-establishment of the position of the original corner.

- Power Pole S73°W 37.36' (P.K. nail in S. side)
- 16" B. Oak S49°W 207.83' (dock spike in N.W. side) #10
- 4" Elm S31°E 39.76' (60d spike in S.W. side)
- 6" Maple N58°W 78.76' (60d spike in N. side)
- 7" Maple S89°W 100.35' (60d spike in N. side)

Signed by Robert L. Wetherell Date 12-12-97
 Surveyor's Michigan License No. 24624

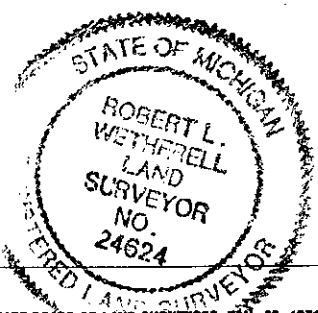

**SURVEY &
REMONUMENTATION**

JAN 14 1998

LIBER004 PAGE0096

SECTION

CONTINUATION OF "A" - DESCRIPTION OF ORIGINAL MONUMENT AND ACCESSORIES AND/OR SUBSEQUENT RESTORATION:

1959 - George Blass, LS 5489

"Set a 5/8" iron pin from Nicholson's witness of 1905"

#8 - 16" Elm N27°E 62.25'

#5 - 36" W. Pine Stump S59°E 35.97'

#9 - Power Pole S85°W 36.67'

1967 - Robert Griffin, U.S.F.S. - LS 13584

L.C.R.C. - Liber 01, Page 256.

Found 5/8" Pipe- replaced with 5" Square Concrete Monument

#10 - 10" B. Oak S44°W 207.90'

#9 - Power Pole S73°W 36.68'

#11 - Pine Post West 33.10'

#12 - 14" Cedar S66°E 155.09'

1973 - Clinton E. Cole, LS 17615

Survey recorded in Liber 01, Page 336.

Witnesses same as Griffin's