

SURVEY & REMONUMENTATION

DEC 9 1999

SECTION

LAND CORNER RECORDATION CERTIFICATE

FILING REQUIREMENT OF ACT 74, Mich. P.A. 1970

RECORDED
LAKE COUNTY, MI.
LIBER 004 PAGE 0240
DEC 9 9 59 AM '99
Shirley Myers
REGISTER OF DEEDS

For corners in Lake	Located in:	Corner Code#
1. Public Land Survey	T 20N	R 14W M-12
	T 20N	R 13W A-12 ✓
	T	R
	T	R
2. Property Controlling s in Section	T	R
	S T	R
3. Miscellaneous Property in Sec.	S T	R
	S T	R
4. Lot No. _____ Recorded Plat _____		
5. Private Claims _____		

Register of Deeds Stamp & File Number

	A	B	C	D	E	F	G	H	I	J	K	L	M
1													
2	6	5	4	3	2	1							
3													
4	7	8	9	10	11	12							
5													
6	18	17	16	15	14	13							
7													
8	19	20	21	22	23	24							
9													
10	30	29	28	27	26	25							
11													
12	31	32	33	34	35	36							
13													

I, Robert L. Wetherell, in a field survey on September 24, 1999, do hereby certify that under requirements of P.A. 74, Michigan P.A. of 1970, the corner points mentioned in lines 1 and 2 above were in conformance with regulations and rules therefore as required in the current manual of survey instructions of the United States Department of the Interior, Bureau of Land Management or by decree of a Court of Law and/or that the corner points mentioned in lines 3, 4, and 5 above were in conformance with the rules of the Michigan Board of Land Surveyors or by a Decree of a Court of Law; established, re-established, monumented, re-monumented, recovered, found as expressed below:

M-12 - 1/4 Cor. Sec. 36, T20N, R14W - A-12 - 1/4 Cor. Sec. 31, T20N, R13W, Lake Co., Mi.

A. Description of original monument and accessories and/or subsequent restoration:

1837 - J. Mullet, G.L.O.
#1 - 10" W. Pine N13°W 28 Links
#2 - 8" W. Pine S78°W 50 Links

1907 - J. Millard
"Found probable remnants of bearing trees"
#3 - 10" B. Oak N6°W 58 Links
#4 - 8" B. Oak N70°W 34 Links

1921 - G.H. Johnson, Co. Sur.
1/4" x 2" x 24" iron
#5 - 12" B. Oak S28°W 22'
#6 - 16" B. Oak N19°E 47'

1949 - G. Blass, LS 5489
Found Iron Leaf Spring
#7 - 8" B. Oak N82°W 35.6'
#6 - 20" B. Oak N17°E 46.4'
#8 - 16" B. Oak S50°E 73.5'

1967 - R.A. Griffin, 13584
L.C.R.C. - Liber 01, Pg. 264
"Corner destroyed by road construction"
Set monument from old bearing trees.
#9 - 6" W. Oak S88°E 65.10'
#10 - 9" W. Oak S26°W 112.31'
#11 - 6" B. Oak N44°W 75.14'

B. Description of corner evidence found and/or method applied in restoring or reestablishing corner:

I found Griffin's 5" Square Concrete Monument in center of North and South Roads.


Condition of the accessories are as follows: #1 Gone, #2 Gone, #3 Gone, #4 Gone, #5 gone, #6 Gone, #7 Found in good condition, #8 Gone, #9 Found in good condition, #10 Found in good condition.

C. Description of monument for corner and accessories established to perpetuate locating the position of the corner:

I accepted the 5" Square Concrete Monuement as a substantial maker for the corner, and is accepted as a careful and faithful reestablishment of the position of the original corner.

- 19" B. Oak N82°W 35.77' (60d in S. side) #7
- 9" W. Oak S85°E 65.10' (dock spike in N. side) #9
- 13" W. Oak S28°W 112.24' (dock spike in S.E. side) #10
- 10" B. Oak N41°W 75.08' (dock spike in N.E. side) #11
- 4" x 4" Post East 32.71' (nail and cap S. side)

VALIDATED BY THE LAKE CO. PEER REVIEW GROUP
IN ACCORDANCE WITH P.A. 345
CHAIRMAN R. S. W.
DATE 10-19-99

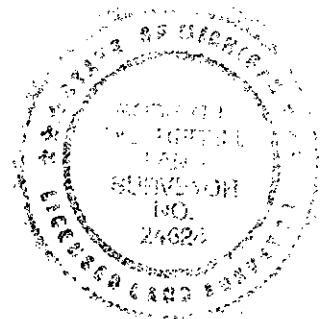

Signed by

Robert L. Wetherell

Date

10/22/99

Surveyor's Michigan License No. 24624