

**SURVEY & REMONUMENTATION**

JAN 14 1998

**SECTION**

**LAND CORNER RECORDATION CERTIFICATE**  
**Filing Requirement of Act 74, Mich. P.A. 1970**

For corners in Lake

(County)	Located In:	Corner Code #
1. Public Land Survey	T <u>20N</u> R <u>13W</u>	<u>C-5</u>
	T _____ R _____	_____
	T _____ R _____	_____
	T _____ R _____	_____
2. Property Controlling in Section	S _____ T _____ R _____	_____
	S _____ T _____ R _____	_____
3. Miscellaneous Property in Sec.	S _____ T _____ R _____	_____
	S _____ T _____ R _____	_____

RECORDED  
 LAKE COUNTY, MI.  
 LIBER 004 PAGE 0101  
 Dec 12 11 38 AM '97

*Lucinda H. Dechard*  
 REGISTER OF DEEDS

Register of Deeds Stamp & File Number

4. Lot No. \_\_\_\_\_, Recorded Plat \_\_\_\_\_  
 5. Private Claims \_\_\_\_\_

	A	B	C	D	E	F	G	H	I	J	K	L	M
2	6	5	4	3	2	1							
3													
4	7	8	9	10	11	12							
5													
6	18	17	16	15	14	13							
7													
8	19	20	21	22	23	24							
9													
10	30	29	28	27	26	25							
11													
12	31	32	33	34	35	36							
13													

I, Robert L. Wetherell, in a field survey on September 22, 19 97, do hereby certify that under requirements of P.A. 74, Michigan P.A. of 1970, the corner points mentioned in lines 1 and 2 above were in conformance with regulations and rules therefore as required in the current manual of survey instructions of the United States Department of the Interior, Bureau of Land Management or by a decree of a Court of Law and/or that the corner points mentioned in lines 3, 4 and 5 above were in conformance with the rules of the Michigan Board of Land Surveyors or by a Decree of a Court of Law; established, re-established, monumented, re-monumented, recovered, found as expressed below:

**NOTE: Not more than 4 corners, all in the same town and range, may be recorded on this certificate.**

A. Description of original monument and accessories and/or subsequent restoration:  
C-5 - Section corner common to Sections 7, 8, 17 & 18, T20N, R13W, Lake Co., Mi.

1839 - J. Brink, G.L.O.

#1 - 10" W. Pine N65°E 37 Links

#2 - 12" Pitch Pine S60-1/2°W 22 Links

1918 - George Johnson, Co. Sur.

1" Pipe, 36" Long

#3 - 6" W. Oak N80°E 76 Links

1959 - George Blass, LS 5489

Found 3/4" Pipe

#4 - 24" B. Oak N37°E 52.35'

#5 - Fence Corner Post S45°E 41.10'

#6 - Power Pole S72°W 38.95'

(SEE OVER FOR CONTINUATION OF "A")

B. Description of corner evidence found and/or method applied in restoring or reestablishing corner:

C-5 - Section corner common to Sections 7, 8, 17 & 18, T20N, R13W, Lake Co., Mi.

I found Griffin's 5" Square Concrete Monument in the intersection of roads North, South, East and West.

Condition of the accessories are as follows: #1 Gone, #2 gone, #3 Gone, #4 Found in good condition, #5 Gone, #6 Found in good condition, #7 Found in good condition, #8 Found in good condition, #9 Found in good condition, #10 Found in good condition.

RATIFIED BY THE LAKE CO. PEER REVIEW GROUP  
 IN ACCORDANCE WITH P.A. 345  
 CHAIRMAN R.S.W.  
 DATE 12-10-97

C. Description of monument for corner and accessories established to perpetuate locating the position of the corner:

C-5 - Section corner common to Sections 7, 8, 17 & 18, T20N, R13W, Lake Co., Mi.

I accepted the 5" Square Concrete Monument as a substantial marker for the corner, and is accepted as a careful and faithful re-establishment of the position of the original corner.

11" W. Oak N61°E 88.29' (dock spike in S.E. side) #7

Power Pole S71°W 38.95' (spike and washer in S.E. side) #6

11" W. Oak N68°W 84.94' (dock spike in N.E. side) #8


7" W. Oak N47°W 116.73' (dock spike in S.W. side) #9

Signed by Robert L. Wetherell

24624

Date 12-12-97

Surveyor's Michigan License No. \_\_\_\_\_

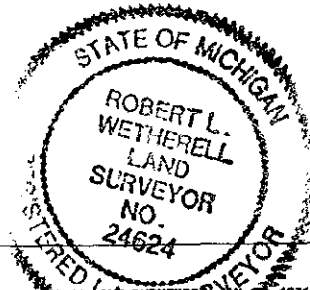

JAN 14 1998

LIBER004 PAGE 0102

SECTION

CONTINUATION OF "A" - DESCRIPTION OF ORIGINAL MONUMENT AND ACCESSORIES AND/OR SUBSEQUENT RESTORATION:

1967 - Robert Griffin, LS 13584

Found 3/4" x 36" Pipe.

Replaced with a 5" Square Concrete Monument

#7 - 8" W. Oak N57°E 88.41'

#6 - Power Pole S72°W 38.95'

#8 - 8" W. Oak N72°W 84.94'

#9 - 6" W. Oak N52°W 116.75'

1990 - Clinton E. Cole, LS 17615

Survey recorded in Liber 03, Page 228.

Same witnesses as Griffins No. 7, 6, 8 & 9

#10 - 1/2" Capped Iron West 33.00'