

MICHIGAN BOARD OF LAND SURVEYORS  
 COMMISSION

**LAND CORNER RECORDATION CERTIFICATE**  
**Filing Requirement of Act 74, Mich. P.A. 1970**

LIBER 003 PAGE 0278

For corners in

Lake _____ (County)	Located in:	Corner Code #	
1. Public Land Survey	T <u>20N</u> R <u>13W</u>	G-8	
	T _____ R _____		
	T _____ R _____		
	T _____ R _____		
2. Property Controlling in Section	S _____ T _____ R _____		
	S _____ T _____ R _____		
3. Miscellaneous Property in Sec.	S _____ T _____ R _____		
	S _____ T _____ R _____		

STATE OF MICHIGAN ) RECORDED 14 DAY OF  
 COUNTY OF LAKE ) Nov 19 94 A.D. at  
 O'Clock 11:30 A.M.  
*James K. DeLeon* REGISTER OF DEEDS

**Register of Deeds Stamp & File Number**

4. Lot No. \_\_\_\_\_, Recorded Plat \_\_\_\_\_  
 5. Private Claims \_\_\_\_\_

	A	B	C	D	E	F	G	H	I	J	K	L	M
2	6	5	4	3	2	1							
3													
4	7	8	9	10	11	12							
5													
6	18	17	16	15	14	13							
7													
8	19	20	21	22	23	24							
9													
10	30	29	28	27	26	25							
11													
12	31	32	33	34	35	36							
13													

I, Robert L. Wetherell, in a field survey on June 26, 19 94, do hereby certify that under requirements of P.A. 74, Michigan P.A. of 1970, the corner points mentioned in lines 1 and 2 above were in conformance with regulations and rules therefore as required in the current manual of survey instructions of the United States Department of the Interior, Bureau of Land Management or by a decree of a Court of Law and/or that the corner points mentioned in lines 3, 4 and 5 above were in conformance with the rules of the Michigan Board of Land Surveyors or by a Decree of a Court of Law; established, re-established, monumented, re-monumented, recovered, found as expressed below:

**NOTE: Not more than 4 corners, all in the same town and range, may be recorded on this certificate.**

A. Description of original monument and accessories and/or subsequent restoration:  
 G-8 - 1/4 Corner common to Sections 21 and 22, T20N, R13W, Eden Township, Lake Co., Mi.  
 1839 - John Brink, G.L.O.                      1983 - Robert L. Wetherell, LS 24624  
 #1 - 18" Y. Pine S77°E 12 Links              L.C.R.C. Liber 03, Page 002. Set 1/2" rod on line between Sec. Cor's. and on an extension of a line from E.1/4 cor. Sec. 22 to C.1/4 Sec. 22. The C.1/4 Sec. 22 was established by George Johnson (Co. Sur.) in 1913. I measured the following distances: 2680.47' to N.E. cor. of Sec. 21; 2674.13' to S.E. cor. of Sec. 21; 2669.35' to C.1/4 of Sec. 22; 2728.05' to C.1/4 Sec. 21, (comp)  
 #2 - 8" Maple S81-1/2°W 48 Links  
 #3- 10" W. Oak S25°W 77.33'  
 #4 - 8" W. Oak N72°W 49.31'  
 #5 - 8" B. Oak N59°E 64.85'  
 (SEE OVER FOR CONTINUATION OF "A")


B. Description of corner evidence found and/or method applied in restoring or reestablishing corner:  
 G-8 - 1/4 Corner common to Sections 21 and 22, T20N, R13W, Eden Township, Lake Co., Mi.  
 I found the 5" square concrete monument. Condition of the accessories is as follows: #1 Gone, #2 Gone, #3 Found in good condition, #4 Found in good condition, #5 Found in good condition, #6 Found in good condition, #7 Found in good condition, #8 Found in good condition, #9 Found in good condition.

RATIFIED BY THE LAKE CO. PEER REVIEW GROUP  
 IN ACCORDANCE WITH P.A. 345  
 CHAIRMAN G. T. W.  
 DATE 11/8/94

C. Description of monument for corner and accessories established to perpetuate locating the position of the corner:  
 G-8 - 1/4 Corner common to Sections 21 and 22, T20N, R13W, Eden Township, Lake Co., Mi.  
 I accepted the 5" square U.S.F.S. concrete monument as a substantial monument for the corner, and is accepted as a careful and faithful re-establishment of the position of the original corner.

- 7" R. Pine N40°W 10.73' (60d spike in S.W. side of tree) (#6)
- 10" B. Oak N58°E 64.82' (60d spike in N.W. side of tree) (#5 & #7)
- 12" W. Oak S22°W 77.34' (60d spike in S.E. side of tree) (#3 & #8)
- 10" W. Oak N70°W 49.35' (60d spike in N. side of tree) (#4)

Signed by Robert L. Wetherell Date 11-9-94  
 24624

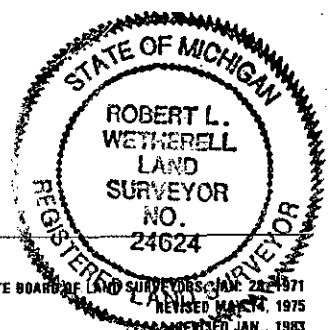

CONTINUATION OF "A" - DESCRIPTION OF ORIGINAL MONUMENT AND ACCESSORIES AND/OR SUBSEQUENT RESTORATION

1989 - Sammy Barnett, L.S. 16923

Replaced 1/2" Iron with 5" Square

U.S.F.S. Concrete Monument

#6 - 5" R. Pine N40°W 10.73'

#7 - 7" B. Oak N58°E 64.74' (#5)

#8 - 10" W. Oak S22°W 77.34' (#3)

#9 - Carsonite Post 1.0' North

L.C.R.C. Liber 003, Page 90.