

SURVEY & REMONUMENTATION

**JAN 12 1996
COMMISSION**

LAKE COUNTY REMONUMENTATION

**LAND CORNER RECORDATION CERTIFICATE
Filing Requirement of Act 74, Mich. P.A. 1970**

LIBER 003 PAGE 0298


**REGISTERED LAND SURVEYOR
ROBERT L. WETHERELL
NO. 24624**
JUN 8 3 51 PM '95
LAKE COUNTY, MI.
REGISTER OF DEEDS

For corners in

(County)	Located In:	Corner Code #
1. Public Land Survey	T 20N R 14W	C-5
	T _____ R _____	_____
	T _____ R _____	_____
	T _____ R _____	_____
	T _____ R _____	_____
2. Property Controlling in Section	S _____ T _____ R _____	_____
	S _____ T _____ R _____	_____
3. Miscellaneous Property in Sec.	S _____ T _____ R _____	_____
	S _____ T _____ R _____	_____

Register of Deeds Stamp & File Number

4. Lot No. _____, Recorded Plat _____
5. Private Claims _____

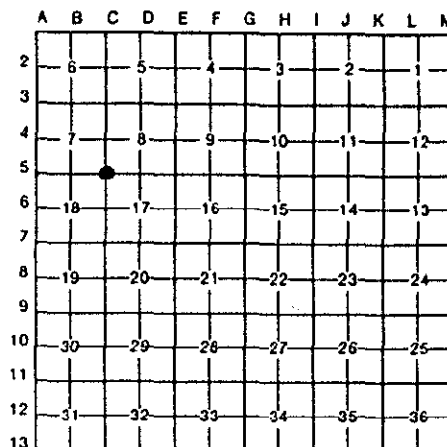

I, Robert L. Wetherell, in a field survey on February 23, 1995, do hereby certify that under requirements of P.A. 74, Michigan P.A. of 1970, the corner points mentioned in lines 1 and 2 above were in conformance with regulations and rules therefore as required in the current manual of survey instructions of the United States Department of the Interior, Bureau of Land Management or by a decree of a Court of Law and/or that the corner points mentioned in lines 3, 4 and 5 above were in conformance with the rules of the Michigan Board of Land Surveyors or by a Decree of a Court of Law; established, re-established, monumented, re-monumented, recovered, found as expressed below:

NOTE: Not more than 4 corners, all in the same town and range, may be recorded on this certificate.

A. Description of original monument and accessories and/or subsequent restoration:
C-5 - Section corner common to Sections 7, 8, 17 & 18, T20N, R14W, Elk Twp., Lake Co., Mi.

- | | | |
|---|--|---|
| <u>1839 - John Brink, G.L.O.</u> | <u>Gerald Gray - L.S. 17741</u> | <u>1985 - Clinton Cole - L.S. 17615</u> |
| #1 - 4" Tamarack N12-1/2°E 25 Links | Undated Section breakdown (1970's) | Showed a distance of 2902.36' to West 1/4 corner Section 8. |
| #2 - 7" Hemlock S69°W 35 Links | Showed fence corner for monument. | No monumentation given. |
| <u>1915 - George Johnson, Lake Co. Surveyor</u> | <u>1972 - Sammy Barnett - L.S. 16923</u> | |
| 7/8" Iron Rod in Marsh | L.C.R.C. - Liber 2, Pg. 55. | |
| #3 - 8" Y. Pine N43°E 165-1/2' | Found tack in stake in old corner. | |
| | #4 - 8" W. Pine S53°E 112.20' | |
| | #5 - 8" W. Pine S60°W 89.23' | |

B. Description of corner evidence found and/or method applied in restoring or reestablishing corner:

C-5 - Section corner common to Sections 7, 8, 17 & 18, T20N, R14W, Elk Twp., Lake Co., Mi.

I found a 1/2" re-bar in a fence intersection (North and West). I also found Barnett's accessories #4 & #5 (Dead) that fits this 1/2" re-bar. This Iron Fits distances to the West 1/4 corner of Section 8 as reported by Surveyor's Gray and Cole.

I also recovered the 7/8" round iron rod (Johnson) and the stump of accessory #3 that fit well. The Johnson corner is Southeasterly 34.92 feet from the 1/2" re-bar. I measured a distance of 230 feet more or less to the North edge of the swamp (G.L.O. measured 3.5 Chains [231 feet]). I accepted the Johnson 7/8" rod as the correct corner.


**RATIFIED BY THE LAKE CO. PEER REVIEW GROUP
IN ACCORDANCE WITH P.A. 345
CHAIRMAN A. J. W.
DATE 5-22-95**

C. Description of monument for corner and accessories established to perpetuate locating the position of the corner:

C-5 - Section corner common to Sections 7, 8, 17 & 18, T20N, R14W, Elk Twp., Lake Co., Mi.

I replaced the 7/8" rod with a 3/4" x 24" re-bar with Lake County Brass Cap, and is accepted as a careful and faithful re-establishment of the position of the original corner.

- 16" W. Pine N64°E 161.38' (60d spike in S. side)
- 18" R. Pine N45°E 209.30' (60d spike in N.W. side)
- 10" W. Pine N02°W 294.05' (60d spike in W. side)
- 1/2" Re-bar N63°W 34.92' (in fence intersection)

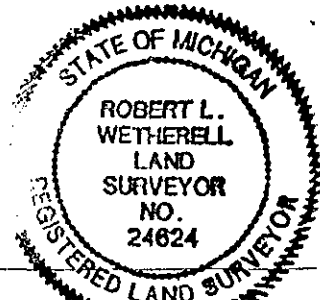

Signed by Robert L. Wetherell

Date May 29, 1995

Surveyor's Michigan License No. 24624