

JAN 1 2 1996

99


COMMISSION

**LAKE COUNTY REMONUMENTATION
LAND CORNER RECORDATION CERTIFICATE
Filing Requirement of Act 74, Mich. P.A. 1970**

LIBER 003 PAGE 0299

For corners in

Lake (County)	Located In:		Corner Code #
	20N	14W	
1. Public Land Survey	T	R	E-5
	T	R	
	T	R	
	T	R	
2. Property Controlling in Section	S	T	R
	S	T	R
3. Miscellaneous Property in Sec.	S	T	R
	S	T	R

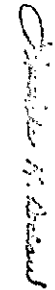
 REGISTER OF DEEDS
 Jun 8 3 51 PM '95
 RECORDED
 LAKE COUNTY, MI.
 Register of Deeds Stamp & File Number

- 4. Lot No. _____, Recorded Plat _____
- 5. Private Claims _____

A	B	C	D	E	F	G	H	I	J	K	L	M
2	6	5	4	3	2							
3												
4	7	8	9	10	11	12						
5												
6	18	17	16	15	14	13						
7												
8	19	20	21	22	23	24						
9												
10	30	29	28	27	26	25						
11												
12	31	32	33	34	35	36						
13												

Robert L. Wetherell, in a field survey on February 23, 1995, do hereby certify that under requirements of P.A. 74, Michigan P.A. of 1970, the corner points mentioned in lines 1 and 2 above were in conformance with regulations and rules therefore as required in the current manual of survey instructions of the United States Department of the Interior, Bureau of Land Management or by a decree of a Court of Law and/or that the corner points mentioned in lines 3, 4 and 5 above were in conformance with the rules of the Michigan Board of Land Surveyors or by a Decree of a Court of Law; established, re-established, monumented, re-monumented, recovered, found as expressed below:

NOTE: Not more than 4 corners, all in the same town and range, may be recorded on this certificate.

A. Description of original monument and accessories and/or subsequent restoration:

E-5 - Section corner common to Sections 8, 9, 16 and 17, T20N, R14W, Lake Co., Mi.

1839 - John Brink, G.L.O.

#1 - 10" Y. Pine N81°E 11 Links

#2 - 8" B. Oak S82°W 16 Links

1907 - J.W. Nicholson, Co. Sur.

#3 - 12" Y. Pine S33°E 141 Links

#4 - 24" W. Pine S40°W 105 Links
Found decayed remnants of old stake and Oak B.T. and also down yellow pine.

(SEE OVER FOR CONTINUATION OF "A")

1915 - George Johnson, Co. Sur.

Stones and tin can filled with broken crockery.


#5 - 7" W. Oak N56° 33 Links

#6 - 7" B. Oak N42°W 39 Links

B. Description of corner evidence found and/or method applied in restoring or reestablishing corner:

E-5 - Section corner common to Sections 8, 9, 16 and 17, T20N, R14W, Lake Co., Mi.

I found the 5" x 60" Concrete Monument set by Griffin. Condition of accessories are as follows: #1 - Remains of stump, #2 - Gone, #3 - Gone, #4 - Gone, #5 - Found Stump, #6 - Found in good condition, #7 - Found in good condition, #8 - Found in good condition, #9 - Found in good condition, #10 - Found in good condition.

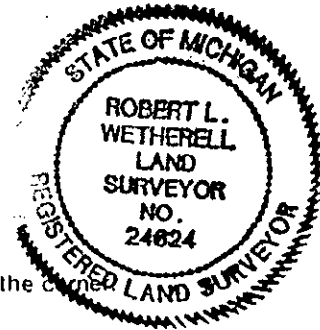

C. Description of monument for corner and accessories established to perpetuate locating the position of the corner:

E-5 - Section corner common to Sections 8, 9, 16 and 17, T20N, R14W, Lake Co., Mi.

I accepted the 5" x 60" Concrete Monument as a substantial marker for the corner, and is accepted as a careful and faithful perpetuation of the position of the original corner.

- 8" R. Pine N14°E 6.30' (10" dock spike in S.E. side) #7
- 12" R. Pine S40°E 79.80' (10" dock spike in N.E. side) #8
- 8" W. Oak S50°W 80.10' (10" dock spike in N.W. side) #9
- 12" R. Pine N28°W 47.85' (10" dock spike in N.E. side) #10

RATIFIED BY THE LAKE CO. PEER REVIEW GROUP
IN ACCORDANCE WITH P.A. 345
CHAIRMAN R. L. W.
DATE 5-22-95

Signed by Robert L. Wetherell Date May 29, 1995
Surveyor's Michigan License No. 24624

SURVEY &
REMONUMENTATION

JAN 1 2 1996

COMMISSION

CONTINUATION OF "A" - DESCRIPTION OF ORIGINAL MONUMENT AND ACCESSORIES AND/OR SUBSEQUENT RESTORATION:

1963 - Robert A. Griffin (U.S.F.S.)

L.C.R.C. - Liber 01, Page 334

Found stone and tin can filled with broken crockery and both of Johnson's witness trees. Also found a red pine stump that fits accessory #1. Replaced stone with a 5" x 60" Concrete Monument.

7 - 8" Forked R. Pine N14°E 6.30'

8 - 7" R. Pine S40°E 79.80'

9 - 5" W. Oak S50°W 80.10'

#10 - 10" R. Pine N28°W 47.80'

1972 - Sammy Barnett, LS 16923

U.S.F.S. Concrete Monument

L.C.R.C. - Liber 02, Page 55

8 - 8" R. Pine S42°E 79.82'

7 - 6" R. Pine (Tw.) N13°E 6.38'

#10 - 10" R. Pine N28°W 47.83'