

SURVEY & REMONUMENTATION

MAY 18 1998

LIBER 004 PAGE 0140

LAND CORNER RECORDATION CERTIFICATE
Filing Requirement of Act 74, Mich. P.A. 1970

SECTION

For corners in Lake

	Located In:		Corner Code #
	20N	14W	
1. Public Land Survey	T	R	G-4
	T	R	
	T	R	
	T	R	
2. Property Controlling in Section	S	T	R
	S	T	R
3. Miscellaneous Property in Sec.	S	T	R
	S	T	R

REGISTERED
 LAKE COUNTY, MI.
 APR 14 3 05 PM '98
 REGISTER OF DEEDS
 Register of Deeds Stamp & File Number

4. Lot No. _____, Recorded Plat _____
 5. Private Claims _____

Robert L. Wetherell March 4 98
 I, _____, in a field survey on _____, 19____ do hereby state that under requirements of P.A. 74, Michigan P.A. of 1970, the corner points mentioned in lines 1 and 2 above were in conformance with regulations and rules therefore as required in the current manual of survey instructions of the United States Department of the Interior, Bureau of Land Management or by a decree of a Court of Law and /or that the corner points mentioned in lines 3, 4 and 5 above were in conformance with the rules of the Michigan Board of Land Surveyors or by a Decree of a Court of Law, established, re-established, monumented, recovered, found as expressed below:

NOTE: Not more than 2 corners, all in the same town and range, may be recorded on this certificate.

A	B	C	D	E	F	G	H	I	J	K	L	M
1												
2	6	5	4	3	2	1						
3												
4	7	8	9	10	11	12						
5												
6	18	17	16	15	14	13						
7												
8	19	20	21	22	23	24						
9												
10	30	29	28	27	26	25						
11												
12	31	32								35		
13												

A. Description of original monument and accessories and/or subsequent restoration:
 G-4 - 1/4 Corner common to Section 9 & 10, T20N, R14W, Elk Twp., Lake Co., Mi.
 1839 - J. Brink, G.L.O. 1907 - Millard County Surveyor
 15" Y. Pine For Corner "Found Yellow Pine Stump 2 Chains West and 84 Links South of stake about on line with Meander Corner and Northeast Section corner".
 #1 - 22" W. Pine Stump N39°E 29 Links
 #2-6" W. Oak N82°W 20 Links

1908 - Nicholson, County Surveyor
 "Established corner by conference of surveyors Barker, Mitchell, Nicholson and Millard
 #3 - 20" Pine Stump N80°W 45 Links
 #4 - 20" Pine Stump S21°W 43-1/2 Links
 Showed distance South to meander cor. of 599' (G.L.O. Measured 587.4')

B. Description of corner evidence found and/or method applied in restoring or reestablishing corner:

G-4 - 1/4 Corner common to Section 9 & 10, T20N, R14W, Elk Twp., Lake Co., Mi.

I found Johnson's 4" Square Concrete monument 11 feet West of North and South dirt road. I also found a 1-1/2" Pipe driven in along North side of Monument (Spicer's corner). From the old notes, it appears the conference in 1908 disproved Millard's 1907 corner. I accepted the 4" Concrete Monument as the correct corner.

Condition of the accessories are as follows: #1 Gone, #2 Gone, #3 Found in good condition, #4 Found remains, #5 Found in good condition, #6 Found Stump with Clump growing out of it, #7 Found Stump, #8 Found in good condition, #10 Gone, #11 Found in good condition,

C. Description of monument for corner and accessories established to perpetuate locating the position of the corner:

G-4 - 1/4 Corner common to Section 9 & 10, T20N, R14W, Elk Twp., Lake Co., Mi.


I accepted the 4" Concrete Monument as a substantial marker for the corner, and is accepted as a careful and faithful re-establishment of the position of the original corner.

- 11" W. Oak N88°W 41.63' (60d spike in S. side)
- 18" Cedar N78°E 42.29' (60d spike in S. side) #11
- 12" Cedar S52°E 70.55' (60d spike in N.E. side)
- 16" Maple S24°E 68.78' (60d spike in E. side)

FORTIFIED BY THE LAKE CO. PEER REVIEW GROUP
 IN ACCORDANCE WITH P.A. 345
 CHAIRMAN R.X.W.
 DATE 4.9.98

Signed by Robert L. Wetherell
 Surveyor's Michigan License No. 24624

Date 4-14-98

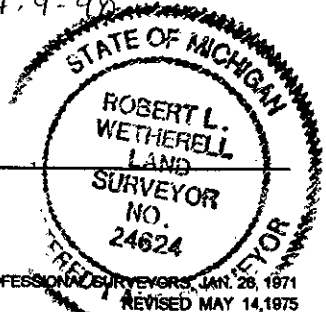

SURVEY &
REMONUMENTATION

MAY 18 1998

LIBER004 PAGE0141

SECTION

CONTINUATION OF "A" - DESCRIPTION OF ORIGINAL MONUMENT AND ACCESSORIES AND/OR SUBSEQUENT RESTORATION:

1927 - G.H. Johnson, County Surveyor

#5 - 12" B. Oak S53°W 43'

#3 - Burn Pine Stump N58°30'W 30'

Undated - George Johnson, County Surveyor

Cement Post

#5 - 12" B. Oak S53°W 43'

1931 - George Johnson, County Surveyor

#6 - 10" B. Oak S52°W 77'

#7 - 10" B. Oak N82°W 47.5'

1958 - G. Blass, LS 5489

Developed the plat of "El-View"

#8 - N.W. corner of Lot 4 is 33' East and 50.8' North

1973 - Francis Spicer, LS 7877

L.C.R.C - Liber 02, Page 59 & Liber 02, Page 171

1-1/2" Iron found by Plats.

#9 - 18" Oak west 32.31'

#10 18" Cedar S50°E 42.60'

#11 - 12" Cedar N75°E 40.95'

Centerline of trail is East 7' more or less.