

NOV 15 1994

COMMISSION

LAND CORNER RECORDATION CERTIFICATE
Filing Requirement of Act 74, Mich. P.A. 1970

LIBER003 PAGE0233

For corners in

Table with columns: Lake (County), Located In: (Town, Range), Corner Code #. Includes entries for Public Land Survey, Property Controlling in Section, and Miscellaneous Property in Sec.

RECORDED LAKE COUNTY, MI.
REGISTER OF DEEDS
OCT 7 3 47 PM '94

Register of Deeds Stamp & File Number

4. Lot No. , Recorded Plat
5. Private Claims

Grid table with columns A-M and rows 2-13. A dot is marked at the intersection of column F and row 10.

I, Robert L. Wetherell, in a field survey on April 27, 1994, do hereby certify that under requirements of P.A. 74, Michigan P.A. of 1970, the corner points mentioned in lines 1 and 2 above were in conformance with regulations and rules therefore as required in the current manual of survey instructions of the United States Department of the Interior, Bureau of Land Management or by a decree of a Court of Law and/or that the corner points mentioned in lines 3, 4 and 5 above were in conformance with the rules of the Michigan Board of Land Surveyors or by a Decree of a Court of Law; established, re-established, monumented, re-monumented, recovered, found as expressed below:

NOTE: Not more than 4 corners, all in the same town and range, may be recorded on this certificate.

A. Description of original monument and accessories and/or subsequent restoration:

G-10 - (1/4 Corner common to Sections 27 and 28, T20N, R14W, Lake Co., Mi.)

- 1839 - John Brink, D.S., G.L.O.
#1 - 8" Hemlock S40°E 13 Links
#2 - 10" Birch N39°W 11 Links

- 1954 - George Blass, L.S. 5489
(1/2" x 18" Pipe)
#3 - P. Pole N30°W 64.53'
#4 - P. Pole N20°E 94.30'
#5 - 12" Hemlock S73°W 72.65'

(SEE OVER FOR CONTINUATION OF "A")

B. Description of corner evidence found and/or method applied in restoring or reestablishing corner:

G-10 - (1/4 Corner common to Sections 27 and 28, T20N, R14W, Lake Co., Mi.)

I found 5" x 36" monument badly damaged by County Road truck, I also found accessories #3, #4 and #8 in good condition, with accessory #5 being gone.


C. Description of monument for corner and accessories established to perpetuate locating the position of the corner:

G-10 - (1/4 Corner common to Sections 27 and 28, T20N, R14W, Lake Co., Mi.)

I replaced the broken concrete monument with a 3/4" x 24" rerod with Lake County Brass Cap, and is accepted as a careful and faithful re-establishment of the position of the original corner.

- 10" W. Pine S53°E 51.87' (60d spike in North side of tree)
4" Wood Post West 31.96' (Nail and Washer in North side) (#8)
P. Pole N31°W 64.50' (Nail with Blass Survey tag) (#3)
Service Pole N23°E 94.30' (Nail with Blass Survey tag) (#4 & #6)

Signed by Robert L. Wetherell Date October 4, 1994
Surveyor's Michigan License No. 24624

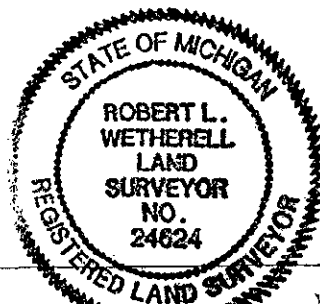

RATIFIED BY THE LAKE CO. PEER REVIEW GROUP IN ACCORDANCE WITH P.A. 345 CHAIRMAN Q.L.W.

CONTINUATION OF "A" - DESCRIPTION OF ORIGINAL MONUMENT AND ACCESSORIES AND/OR SUBSEQUENT RESTORATION

1977 - Robert L. Wetherell, L.S. 24624

Found 1/2" Pipe and Brass witnesses,
#3, #4 and #5. Survey recorded in
Liber 02, Page 162.

1978 - Robert A. Griffin, L.S. 13584

Replaced pipe with 5" x 36" Concrete Monument
#6 - P. Pole N23°E 94.30' (#4)
#7 - 12" Hemlock S70°W 74.60' (#5)
#8 - 4" Post West 31.96'

SURVEYED
REMONSTRATED

NOV 15 1994

COMMISSION