

NOV 21 1997

LAND CORNER RECORDATION CERTIFICATE
Filing Requirement of Act 74, Mich. P.A. 1970

For corners in


COMMISSION

Table with columns: (County), Located in: (20N, 14W, I-7), Corner Code #. Rows include Public Land Survey, Property Controlling in Section, and Miscellaneous Property in Sec.

RECORDED LAKE COUNTY, MI.
REGISTER OF DEEDS
Stamp: Oct 29 2 59 PM '97
File Number

4. Lot No. , Recorded Plat
5. Private Claims

Robert L. Wetherell August 29, 1997
I, in a field survey on, 19, do hereby certify that under requirements of P.A. 74, Michigan P.A. of 1970, the corner points mentioned in lines 1 and 2 above were in conformance with regulations and rules therefore as required in the current manual of survey instructions of the United States Department of the Interior, Bureau of Land Management or by a decree of a Court of Law and/or that the corner points mentioned in lines 3, 4 and 5 above were in conformance with the rules of the Michigan Board of Land Surveyors or by a Decree of a Court of Law; established, re-established, monumented, re-monumented, recovered, found as expressed below:

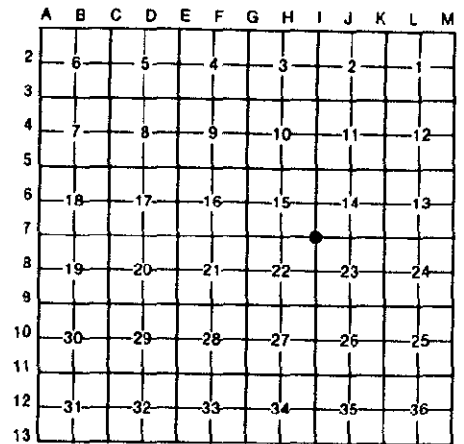

NOTE: Not more than 4 corners, all in the same town and range, may be recorded on this certificate.

A. Description of original monument and accessories and/or subsequent restoration:

I-7 - Section corner common to Sections 14, 15, 22 & 23, T20N, R14W, Lake Co., Mi.

1839 - J. Brink, G.L.O.
#1 - Y. Pine S62°E 19 Links
#2 - Y. Pine S66°W 25 Links

1907 - J. Millard
"Found stake & Bearing Trees"
#3 - 12" Y. Pine S18°E 16 Links
#4 - 12" Y. Pine S2°E 29 Links

1918 - George Johnson, Co. Sur.
3/4" Iron
#5 - 12" B. Oak N88°E 48'


(SEE OVER FOR CONTINUATION OF "A")

B. Description of corner evidence found and/or method applied in restoring or reestablishing corner:


I found a 4" Pipe filled with concrete and Department of Conservation disk on top. Corner is 8 feet North of East and West two track road.

Condition of the accessories are as follows: #1 gone, #2 gone, #3 Gone, #4 Gone, #5 Gone, #6 Found in good condition, #7 Found in good condition, #8 Found in good condition, #9 Gone, #10 Found in good condition, #11 Found in good condition,

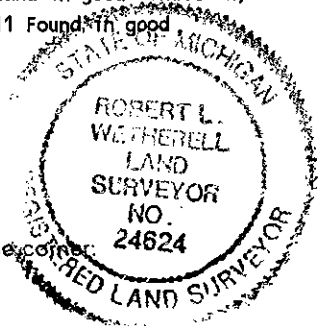

C. Description of monument for corner and accessories established to perpetuate locating the position of the corner:


I accepted the 4" Monument as a substantial marker for the corner, and is accepted as a careful and faithful re-establishment of the position of the original corner.

Survey Iron (17615) South 32.98'
20" B. Oak N41°E 73.42' (60d spike in N.W. side) #6
6" W. Oak N48°W 49.77' (60d spike in N.E. side) #10
10" W. Oak N28°W 41.80' Nail in N.E. side) #8
Clump of 3 Red Oaks S9°W 68.46' (60d spike in W. side)

RATIFIED BY THE LAKE CO. PEER REVIEW GROUP
IN ACCORDANCE WITH P.A. 345
CHAIRMAN RW
DATE 10-23-97

igned by Robert L. Wetherell

Date 10-28-97

urveyor's Michigan License No.

CONTINUATION OF "A" - DESCRIPTION OF ORIGINAL MONUMENT AND ACCESSORIES AND/OR SUBSEQUENT RESTORATION:

1949 - G. Shadko, LS 1934

"Found Millard's Bearing Trees"

#6 - 16" B. Oak N38°30'E 73.6'

#7 - 14" B. Oak S20°30'W 22.2'

1951 - George Blass, LS 5489

Found Conservation Department Marker

#7 - 12" B. Oak S22°W 21.80'

#6 - 16" B. Oak N33°E 72.95'

#8 - 6" W. Oak N32°W 41.50'

#9 - 10" N. Pine S63°W 51.15'

1976 - Robert Griffin, U.S.F.S., LS 13584

L.C.R.C. - Liber 02, Page 284.

Found corner by Shadko

6 - 17" B. Oak N38-1/2°E 73.46'

7 - 14" B. Oak S20°W 22.29'

#10 - 5" W. Oak N51°W 49.78'

#11 - 1/2" Iron South 33.00'

1992 - Norman Ochs, LS 22439

6 - 17" B. Oak N38-1/2°E 73.46'

#11 - Survey Iron #17615 South 33.00'

7 - 14" B. Oak S20-1/2°W 22.29'

#10 - 5" W. Oak N51°W 49.78'

SURVEY &
REMONUMENTATION

NOV 21 1997

COMMISSION