

NOV 21 1997

COMMISSION

LAND CORNER RECORDATION CERTIFICATE
Filing Requirement of Act 74, Mich. P.A. 1970

LIBER 004 PAGE 0080

For corners in

	Located In:		Corner Code #
	20N	14W	
1. Public Land Survey	T	R	I-8
	T	R	
	T	R	
	T	R	
2. Property Controlling in Section	S	T	R
	S	T	R
3. Miscellaneous Property in Sec.	S	T	R
	S	T	R

REGISTER OF DEEDS
Shirley M. Adams
 OCT 29 3 00 PM '97
 RECORDED
 LAKE COUNTY, MI.

Register of Deeds Stamp & File Number

- 4. Lot No. _____, Recorded Plat _____
- 5. Private Claims _____

A	B	C	D	E	F	G	H	I	J	K	L	M
2	6	5	4	3	2	1						
3												
4	7	8	9	10	11	12						
5												
6	13	17	16	15	14	13						
7												
8	19	20	21	22	23	24						
9												
10	30	29	28	27	26	25						
11												
12	31	32	33	34	35	36						
13												

Robert L. Wetherell August 29, 1997
 I, _____, in a field survey on _____, 19____, do hereby certify that under requirements of P.A. 74, Michigan P.A. of 1970, the corner points mentioned in lines 1 and 2 above were in conformance with regulations and rules therefore as required in the current manual of survey instructions of the United States Department of the Interior, Bureau of Land Management or by a decree of a Court of Law and/or that the corner points mentioned in lines 3, 4 and 5 above were in conformance with the rules of the Michigan Board of Land Surveyors or by a Decree of a Court of Law; established, re-established, monumented, re-monumented, recovered, found as expressed below:

NOTE: Not more than 4 corners, all in the same town and range, may be recorded on this certificate.

A. Description of original monument and accessories and/or subsequent restoration:

I-8 - 1/4 Corner common to Sections 22 & 23, T20N, R14W, Lake Co., Mi.

- | | | |
|----------------------------------|-----------------------------------|----------------------------------------|
| <u>1839 - John Brink, G.L.O.</u> | <u>1907 - J. Millard</u> | <u>1916 - George Johnson, Co. Sur.</u> |
| #1 - 10" P. Pine S56°E 23 Links | #3 - W. Pine Stub N47°E 74 Links | 3/4" Iron - 2 feet Long |
| #2 - 10" P. Pine S43°W 14 Links | #4 - Y. Pine Stump S77°W 39 Links | #5 - 9" B. Oak N38°W 28' |
| | | #6 - 10" B. Oak S40°E 55' |

(SEE OVER FOR CONTINUATION OF "A")

B. Description of corner evidence found and/or method applied in restoring or reestablishing corner:

I-8 - 1/4 Corner common to Sections 22 & 23, T20N, R14W, Lake Co., Mi.

I found a 4" Concrete Monument stamped LS 5489 at the extension of centerline of roads South and West.

Condition of the accessories are as follows: #1 gone, #2 Gone, #3 Gone, #4 Gone, #5 Found Stump #6 Gone, #7 Found Stump, #8 Found in good condition, #9 Found in good condition, #10 Found in good condition, #11 Found in good condition, #12 Found in good condition, #13 Found in good condition.


C. Description of monument for corner and accessories established to perpetuate locating the position of the corner:

I-8 - 1/4 Corner common to Sections 22 & 23, T20N, R14W, Lake Co., Mi.

I accepted the 4" Concrete Monument as a substantial marker for the corner, and is accepted as a careful and faithful re-establishment of the position of the original corner.

- 18" B. Oak N68°E 74.36' (dock spike in S.E. side) #8
- 24" B. Oak S51°W 73.56' (spike and washer in S.E. side) #9
- 11" B. Oak N40°E 65.51' (spike and washer in N.E. side) #13
- Power Pole N37°W 39.36' (spike and washer in S.W. side) #12

RATIFIED BY THE LAKE CO. PEER REVIEW GROUP
 IN ACCORDANCE WITH P.A. 345
 CHAIRMAN *RW*
 DATE 10-23-97

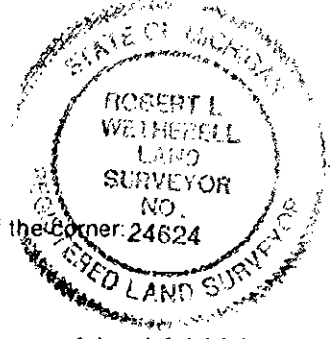

Signed by Robert L. Wetherell
24624

Date 10-28-97

Surveyor's Michigan License No. _____

CONTINUATION OF "A" - DESCRIPTION OF ORIGINAL MONUMENT AND ACCESSORIES AND/OR SUBSEQUENT RESTORATION:

1918 - George Johnson, Co. Sur.

Same as 1916 witnesses.

1949 - G. Shadko, LS 1934

4" Pipe filled with Concrete

#7 - 6" B. Oak N17°W 70.90'

#8 - 6" B. Oak N62°E 73.70'

#9 - 10" Oak S46°W 73.20'

1951 - George Blass, LS 5489

Found 4" Monument

Accessories same as Shadko

1961 - George Blass, LS 5489

Used this corner to developed the plat of "Elko".

The point of beginning of plat is 369.72 feet North of this corner.

1966- Robert Griffin, USFS, LS 13584

L.C.R.C. - Liber 01, Page 338

8 - 11" B. Oak N64°E 74.25'

9 - 15" B. Oak S46°W 73.65'

#11 - Northeast corner Concrete Block Cabin S61°W 188.20'

7 - 9" B. Oak N18°W 71.15'

#12 - Power Pole N39°W 39.65'

#13 - 8" B. Oak N36°E 65.45'

1972 - Clinton E. Cole, LS 17615

Developed the plat of "River Retreat".

This corner being the Southeast corner of the Plat.

Same Accessories as Shadko

#10 - Concrete Monument 33.0' North

SURVEY &
REMONUMENTATION

NOV 21 1957

COMMISSION